

HAR.
K 50

WATER WELL DRILLERS LOG

CODED

Date: July 11, 1963, Driller: H. A. Ladnier County Harrison
(Name)

(1) Owner of Land: <u>Allen Bourque</u> (Name)	Description & Color of Materials Sand, Clay, Red Clay, Shell, etc.	Thick- ness Feet	Depth Feet
<u>Landon road</u> (Address)	<u>Red clay</u> <u>Blue clay</u>	<u>30</u>	<u>60</u>
(2) Location: <u>1/4, 1/4, Sec. 2 T25R12W</u> <u>7 miles north of Long Beach</u> (distance) (direction) (Nearest Town)			
(3) Topography: <u>Hilly</u> (Hilly) (Flat) (Level)			
(4) Purpose of Well: <u>Domestic</u> (Domestic Irrigation Municipal, Industrial, Other)			


CODED

Information upon completion of well:

- (1) Diameter 2 inches.
- (2) Total Depth 210 feet.
- (3) Water level 30 feet below top of ground.
- (4) Cased to 102, Size 2 inch
- (5) Screen: Size 2 inch, length 8
- (6) Were any formations sealed against pollution?
✓ yes, no.

If YES depth of formation 30
Why white sand

Drillers Remarks: _____

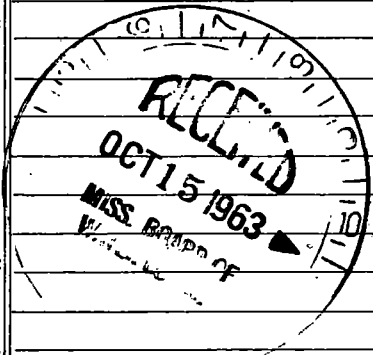

(Use Back Side)

Well No.

