

HAR.

K 51

8-13-63

Date: Aug 13, 1963, Driller: Joe Miller County Harrison

WATER WELL DRILLERS LOG

(Name)

(1) Owner of Land: Mr. Bruce  
(Name)  
APR. Pass Christian Miss  
(Address)

(2) Location: 1/4, 1/4, Sec.     T.     R.      
5 miles N.W., of Gulfport  
(distance) (direction) (Nearest Town)

(3) Topography: Flat  
(Hilly) (Flat) (Level)

(4) Purpose of Well: Domestic  
(Domestic Irrigation  
Municipal, Industrial, Other)

Description & Color of Materials Sand, Clay, Red Clay, Shell, etc.	Thick- ness Feet	Depth Feet
surface	4	4
Red Sand	4	8
Brown Clay	12	20
White Clay	18	38
Blue Clay	4	42
Brown Clay	11	53
Fine Sand, Fine	42	95
" Little-Bella	1	106
Blue Clay	39	145
Sand, Grey-Fine	25	170
Blue Clay (Hard)		195
Sand, Grey Fair	5	200
" " " "	10	210
" " " " Good	10	220
Hard Clay, Blue		223

Information upon completion of well:

(1) Diameter 2 inches.

(2) Total Depth 223' feet.

(3) Water Level 22' feet below top of ground.

(4) Cased to 214', Size 2"

(5) Screen: Size 2", Length 6'


(6) Were any formations sealed against pollution?  
\_\_\_\_\_ yes, \_\_\_\_\_ no.

If YES depth of formation \_\_\_\_\_

Why \_\_\_\_\_

Drillers Remarks: This well

was drilled for home  
to sell. (Robinson Road)

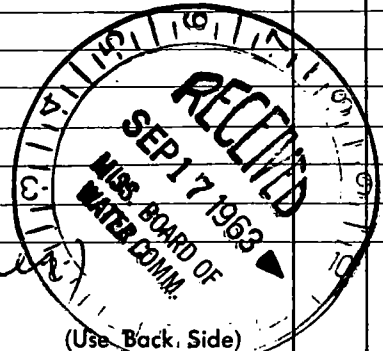

Well No. \_\_\_\_\_

Nugent

Robinson  
Rd



NK4  
49

N.