

HAR:

K54

WATER WELL DRILLERS LOG **CODED**

9-20-63

Date: 9-20, 1963, Driller: Little Well Works County Harrison

(Name)

(1) Owner of Land: G. M. Burney
(Name)
New Orleans, La.
(Address)

(2) Location: NW 1/4, NE 1/4, Sec. 33 T15R12W
5 miles NE of P.C.
(distance) (direction) (Nearest Town)

(3) Topography: flat
(Hilly) (Flat) (Level)

(4) Purpose of Well: domestic
(Domestic Irrigation, Municipal, Industrial, Other)

Description & Color of Materials Sand, Clay, Red Clay, Shell, etc.	Thick- ness Feet	Depth Feet
<u>Drilled clay</u>	<u>28</u>	<u>28</u>
<u>sand with gravel</u>	<u>35</u>	<u>63</u>
<u>Clay</u>	<u>155</u>	<u>218</u>
<u>sand</u>	<u>10</u>	<u>228</u>
<u>Clay - sand streaks</u>	<u>213</u>	<u>441</u>
<u>sand</u>	<u>63</u>	<u>504</u>

CODED

Information upon completion of well:

(1) Diameter 2 inches.

(2) Total Depth 504 feet.

(3) Water Level 1 feet above below top of ground.

(4) Cased to all, Size 2"


(5) Screen: Size 2', Length 16'

(6) Were any formations sealed against pollution?
no.

If YES depth of formation _____

Why _____

Drillers Remarks: _____

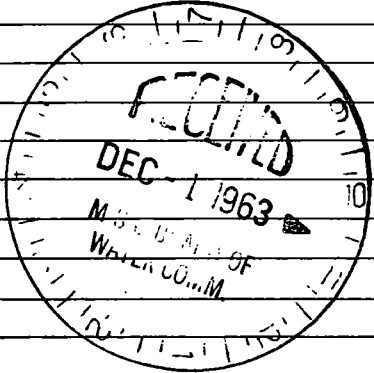

(Use Back Side)

Well No.

0000

[Faint, illegible text throughout the page]

