

Harrison
 K 69 56
 8-67

MISSISSIPPI
 BOARD OF WATER COMMISSIONERS
 416 North State Street
 Jackson, Mississippi 39201

DED

WATER WELL DRILLERS LOG

8-17 1967 date well completed
 Lutter Well Works firm name
 Harrison county well located

LANDOWNER: Roy Allen
 Beatline Road
 Long Beach, Miss.
 (mailing address)

description of formations encountered	from	to
Clay	0	18
Sand	18	25
Clay	25	202
Sand	202	226


WELL LOCATION:
 sec 34 T 7 R 12 E S 3
 3 miles N of Long Beach
 (distance) (direction) (nearest town)

WELL PURPOSE: home
 (home, irrigation, municipal, industrial)

WELL COMPLETION DATA:

- (1) diameter (inches) 2
- (2) total depth (feet) 226
- (3) static water level (feet) 9 below top of ground.
- (4) casing galv. 216' (material) (depth)
 2" (size) if telescope see back.
- (5) screen 10' 216' (length) (depth to top)
 2" stainless steel (size) (material)
- (6) pump unknown (HP) (yield gpm)
- (type power)
- (7) electric log no (yes or no)
- (organization running log)
- (8) how well bottom plugged B.P. Value

CODED

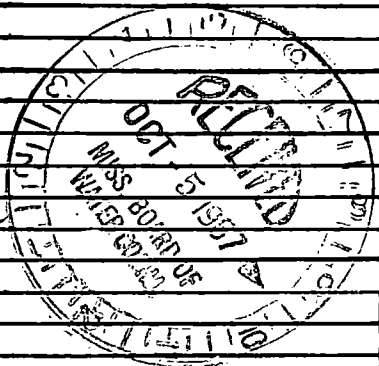

DRILLERS REMARKS:

