

HAR.

MISSISSIPPI BOARD OF WATER COMMISSIONERS

K 59

7-24-64

WATER WELL DRILLERS LOG

Date: July 24, 1964, Driller: Joe Miller County Harrison

(1) Owner of Land: Colored Church Canal Road, Gulfport

(2) Location: 1/4, 1/4, Sec. T R 4 miles N.W. of Gulfport

(3) Topography: Flat


(4) Purpose of Well: Domestic

Table with 3 columns: Description & Color of Materials, Thickness Feet, Depth Feet. Rows include: Spruce, Wh Sand & Pea Gravel, White Brown Clay, Hard Blue Clay, Break fine sand, Clay & sand, Break rock, Fine fine sand, Fine sand fine, Blue Clay.

Information upon completion of well:

- (1) Diameter 2 inches.
(2) Total Depth 224 feet.
(3) Water Level 22 feet below top of ground.
(4) Cased to 208, Size 2"
(5) Screen: Size 2", Length 10'
(6) Were any formations sealed against pollution? yes, no.

If YES depth of formation
Why
Drillers Remarks:

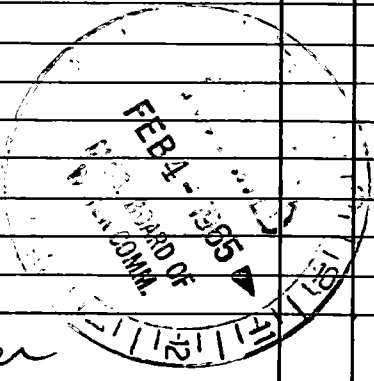

over

(Use Back Side)

Well No.

