

Coded

MISSISSIPPI
BOARD OF WATER COMMISSIONERS
416 North State Street
Jackson, Mississippi 39201

WATER WELL DRILLERS LOG

JACKSON

K60

5-68

may 3 1968
date well completed

L. L. Garland water wells
firm name

Jackson
county well located

LANDOWNER: Richard Steelman

description of formations encountered

from

to

Ocean Springs, Miss
(mailing address)

WELL LOCATION:

sec. 21 T. 6 N. R. 7 E.
5 miles south E. of D.L.
(distance) (direction) (nearest town)

WELL PURPOSE: home
(home, irrigation, municipal, industrial)

WELL COMPLETION DATA:

(1) diameter (inches) 2"
(2) total depth (feet) 346
(3) static water level (feet) 22 ^{below} above top of ground.

(4) casing (material) (depth)
 (size) If telescope see back.

(5) screen 10ft (length) (depth to top)
2" (size) brass (material)

(6) pump 1/2 (HP) (yield gpm)
electric (type power)

(7) electric log (yes or no)

 (organization running log)


(8) how well bottom plugged 2 1/2 valve

JUN - 4 1968
MISS. BOARD OF
WATER COMM.

DRILLERS REMARKS: 52 ft
water bearing sand

If well telescopes please sketch and show depths.

GROUND LEVEL

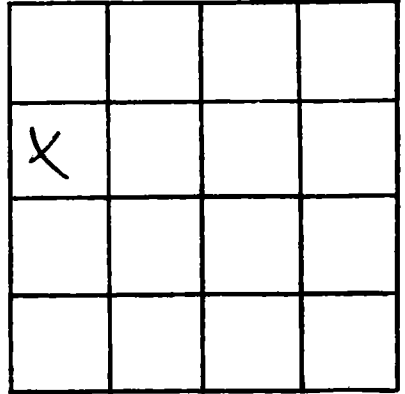

SECTION _____

Please indicate well location X.

ADDITIONAL INFORMATION

If more than one screen, show locations of each on sketch.