

HARRISON

K 62

5-31-66

MISSISSIPPI BOARD OF WATER COMMISSIONERS

WATER WELL DRILLERS LOG

CODED

Date: 5-31, 1966, Driller: C.T. Switzer Well Co. County: Harrison

(When well drilled)

(Name)

(Where well is located)

(1) Owner of Land: Seroy Hughes
(Name)
County Farm Road, Gulfport
(Address)

(2) Location: 1/4, 1/4, Sec. 9 T7^SR12^W
miles. of
(distance) (direction) (Nearest Town)

(3) Topography: X
(Hilly) (Flat) (Level)

(4) Purpose of Well: domestic
(Domestic Irrigation, Municipal, Industrial, Other)

Description & Color of Materials Sand, Clay, Red Clay, Shell, etc.	Thick- ness Feet	Depth Feet
Hard clay	0	21
clay	21	66
sand	66	81
sand with 6" rock	81	101
clay	101	126
sand	126	151
clay	151	161
sand, fair	161	181
sand	181	191
clay	191	221
clay and streaks	221	241
clay	241	286
sand	286	313

Information upon completion of well:

(1) Diameter 2 inches.

(2) Total Depth 313 feet.

(3) Water Level 19' feet below top of ground.

(4) Cased to 313', Size 2"

(5) Screen: Size 8 ga SS, Length 10'

(6) Were any formations sealed against pollution?
X yes, _____ no.

CODED

If YES depth of formation _____


Why Health Dept. Request.

Drillers Remarks: _____

Yield in gpm: _____

Size pump: _____

Type power: _____

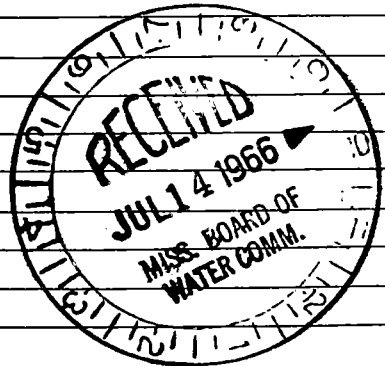

Mail this copy to Board of Water Commissioners 429 Miss. St. Jackson, Miss.

