

Harrison

K63

6-66 MISSISSIPPI BOARD OF WATER COMMISSIONERS

WATER WELL DRILLERS LOG **CODED**

Date: 6-7, 1966, Driller: ET Switzer Well Co. County Harrison
(When well drilled) (Name) (Where well is located)

(1) Owner of Land: P.M. Beasley
(Name)
Landon Rd - Gulfport
(Address)

(2) Location: SW 1/4, SE 1/4, Sec. 10 T7 S R12
_____ miles _____ of _____
(distance) (direction) (Nearest Town)

(3) Topography: X
(Hilly) (Flat) (Level)

(4) Purpose of Well: domestic
(Domestic Irrigation
Municipal, Industrial, Other)

Description & Color of Materials Sand, Clay, Red Clay, Shell, etc.	Thick- ness Feet	Depth Feet
clay	0	36
sands	36	51
clay	51	81
sand	81	95
clay	95	101
mixed	101	121
clay	121	161
sand	161	231

Information upon completion of well:

(1) Diameter 2 inches.

(2) Total Depth 231 feet.

(3) Water Level 23 - feet below top of ground.

(4) Cased to 231', Size 2"

(5) Screen: Size 8ga 55, Length 10'

(6) Were any formations sealed against pollution?
X yes, _____ no.

If YES depth of formation _____

Why: Health Dept. Regments.


Drillers Remarks: _____

Yield in gpm: _____

Size pump: _____

Type power: _____

CODED

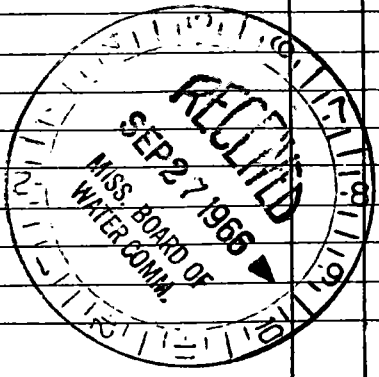

Mail this copy to Board of Water Commissioners 429 Miss. St. Jackson, Miss.

