

Harrison
11-65
11-66

MISSISSIPPI BOARD OF WATER COMMISSIONERS

WATER WELL DRILLERS LOG **CODED**

Date: 11-7, 1966, Driller: C.T. Switzer Well Co. County: Harrison
 (When well drilled) (Name) (Where well is located)

1) Owner of Land: Ray O'Briant
 (Name)
Route 3 Box 536, Gulfport
 (Address)
 2) Location: NE 1/4, NW 1/4, Sec. 6 T7 R12W
ROBINSON ROAD
 miles _____ of _____
 (distance) (direction) (Nearest Town)
 3) Topography: X
 (Hilly) (Flat) (Level)
 4) Purpose of Well: domestic
 (Domestic Irrigation
 Municipal, Industrial, Other)


Description & Color of Materials Sand, Clay, Red Clay, Shell, etc.	Thick- ness Feet	Depth Feet
clay & sand streaks	0	20
sand + gravel	20	21
sand + gravel	21	24
clay + red sand	24	42
clay	42	61
sandy clay	61	81
clay	81	117
sand	117	125
clay	125	136
sand	136	235
mixed sand	235	241
sand	241	244
clay	244	249
sand	249	265
fine sand	265	269
mixed	269	275
good sand	275	286
clay	286	287
sand	287	290
clay	290	297
sand	297	303
clay	303	522
fine sand	522	531
sand	531	535
shale	535	547
sand	547	556
shale + fine sand	556	568
shale	568	573
good sand	573	584
clay	584	646
sand	646	651
fine sand	651	664

CODED

Information upon completion of well:

1) Diameter 2 inches.
 2) Total Depth 725 feet.
 3) Water Level 35' feet below top of ground.
 4) Cased to 725', Size 2"
 5) Screen: Size 8ga SS Length 10'
 5) Were any formations sealed against pollution?
X yes, _____ no.

YES depth of formation _____
 My Health Dept. (Signatures)
 Drillers Remarks: _____
 Yield in gpm: _____
 Size pump: 1/2 Horsepower
 Type power: _____

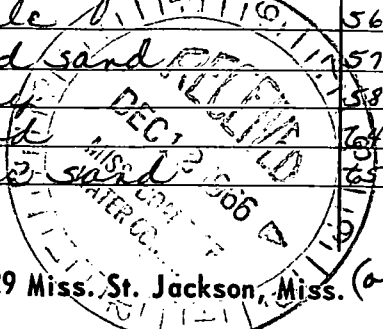

Send this copy to Board of Water Commissioners 429 Miss. St. Jackson, Miss. (over)

664-692 good sand
692-715 sand