

MISSISSIPPI  
 BOARD OF WATER COMMISSIONERS  
 416 North State Street  
 Jackson, Mississippi 39201

**CODED**

WATER WELL DRILLERS LOG

HARRISON  
 K 66  
 1-67

Jan 12, 1967 Hattiesburg Butane Harrison  
 date/well completed firm name county well located

LANDOWNER: Micky James  
 Rt. 1 Box 484 county road  
 Landon Road + sub  
 Gulfport, Miss  
 (mailing address)

WELL LOCATION: 12  
 sec. 9 T 7 N R 2 E  
 7 miles West of Landon  
 (distance) (direction) (nearest town)


WELL PURPOSE: Home  
 (home, irrigation, municipal, industrial)

WELL COMPLETION DATA:

- (1) diameter (inches) 2"
- (2) total depth (feet) 115'
- (3) static water level (feet) 25' below top of ground.
- (4) casing Galv 102'  
 (material) (depth)  
 2" if telescope see back.  
 (size)
- (5) screen 10' 105'  
 (length) (depth to top)  
 2" bronze  
 (size) (material)
- (6) pump 1 HP 400  
 (HP) (yield gpm)  
 E/EC  
 (type power)
- (7) electric log No  
 (yes or no)  
 (organization running log)
- (8) how well bottom plugged Back  
 wash valve

description of formations encountered	from	to
Red Sand	0	20
White sand	20	28
Red Sand	28	30
White clay	30	37
White sand	37	47
Blue clay	47	98
Blue sand	98	115

**CODED**

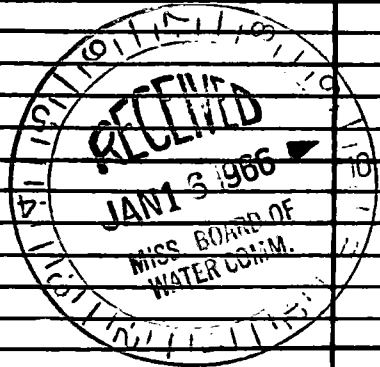

DRILLERS REMARKS:

If well telescopes please sketch and show depths.

GROUND LEVEL


SECTION \_\_\_\_\_

Please indicate well location X.

ADDITIONAL INFORMATION

If more than one screen, show locations of each on sketch.