

Harrison  
K 67  
3-67

MISSISSIPPI  
BOARD OF WATER COMMISSIONERS  
416 North State Street  
Jackson, Mississippi 39201

**CODED**

WATER WELL DRILLERS LOG

3-23 1967 date well completed Switzer Well Co. firm name Harrison county well located

LANDOWNER: H. H. Hilton  
1/8 mile West of Daugherty Rd.  
on Three Notch Road

description of formations encountered

from to

P.O. Box 51, Long Beach  
(mailing address)

sandy clay	0	10
sand	10	22
coarse white sand	22	44
sand	44	48
soft clay	48	60
sand	60	79
soft clay	79	106
clay	106	289
sand	289	294
clay	294	414
good sand	414	429
clay	429	464
sand	464	476
clay	476	478
sand + clay streak	478	487
good sand	487	494
sand	494	495
clay	495	512
sand	512	514
sand + clay	514	535
mixed	535	545
shale	545	561
good sand	561	590
band with rock	590	597
good sand	597	616

WELL LOCATION:


sec. 10 T. 7 S. R. 12 W.  
3 miles N of LONG BEACH  
(distance) (direction) (nearest town)

WELL PURPOSE: home  
(home, irrigation, municipal, industrial)

WELL COMPLETION DATA:


- diameter (inches) 2
- total depth (feet) 616
- static water level (feet) 2 below top of ground.
- casing gal. steel, 596' (material) (depth)  
2" If telescope see back. (size)
- screen 20' (length), 596' (depth to top)  
2" (size), 10 ga ss on pipe (material)
- pump Not installed (HP) (yield gpm)  
(type power)
- electric log No (yes or no)  
(organization running log)
- how well bottom plugged back  
pressure valve

DRILLERS REMARKS:

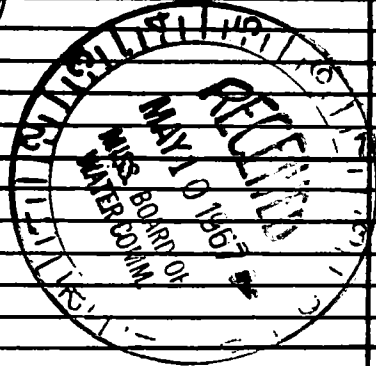

If well telescopes please sketch and show depths.

GROUND LEVEL

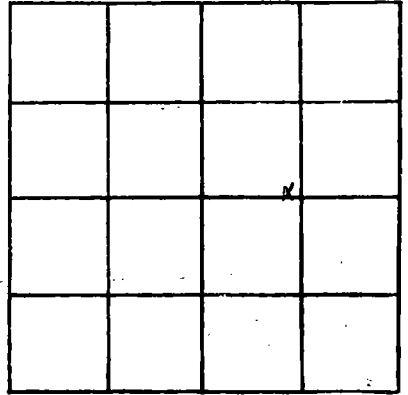

SECTION 10

Please indicate well location X.

ADDITIONAL INFORMATION

Lined area for additional information.

If more than one screen, show locations of each on sketch.