

Harrison  
K 68  
4-67

MISSISSIPPI  
BOARD OF WATER COMMISSIONERS  
416 North State Street  
Jackson, Mississippi 39201

**CODED**

WATER WELL DRILLERS LOG

4-29 1967 MFB Drilling Co. Harrison  
date well completed firm name county well located

LANDOWNER: Robert Tolly  
Bosarge Rd  
Long Beach, Miss.  
(mailing address)


WELL LOCATION:  
sec. 35 T 7 R 12 S W  
2 miles NW of Long Beach  
(distance) (direction) (nearest town)

WELL PURPOSE: Home  
(home, irrigation, municipal, industrial)

WELL COMPLETION DATA:  
(1) diameter (inches) 2  
(2) total depth (feet) 252  
(3) static water level (feet) 32 1/2 below top of ground  
(4) casing PVC 2 1/2 (material) (depth)  
2" if telescope see back. (size)  
(5) screen 6 FT 252 (length) (depth to top)  
2" PVC Sand Pac (size) (material)  
(6) pump 3/4 15 (HP) (yield gpm)  
110 V 10 (type power)  
(7) electric log No (yes or no)  
(organization running log)  
(8) how well bottom plugged PVC Cap

description of formations encountered	from	to
Surface	0	4
Clay	4	8
Sand & Clay	8	10
White Sand	10	16
Sand & Clay Breaks	16	22
White Sand	22	33
Light Blue Clay	33	53
Dark Blue Clay	53	105
Sand & Clay Breaks	105	120
Blue Clay	120	133
Sand	133	135
Blue Clay	135	150
Sand & Clay Breaks	150	160
Blue Clay	160	195
Fine Powder Clay	195	208
Sand	208	236
Blue Clay	236	252
Sand	252	

**CODED**

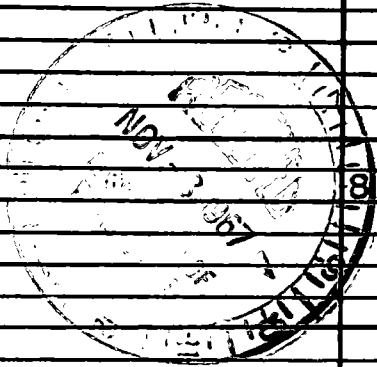

DRILLERS REMARKS:

