

HARRISON  
K 71  
2-68

MISSISSIPPI  
BOARD OF WATER COMMISSIONERS  
416 North State Street  
Jackson, Mississippi 39201

CODED

WATER WELL DRILLERS LOG

2-20 1968  
date well completed

Sutter Well Works  
firm name

Harrison  
county well located

LANDOWNER: Noel Cornish

Rt 1 Box 549

Gulfport Miss.  
(mailing address)

WELL LOCATION:

sec. 33 T 7 R 12 S W

2 miles N of Osceola  
(distance) (direction) (nearest town)

WELL PURPOSE: home  
(home, irrigation, municipal, industrial)

WELL COMPLETION DATA:

(1) diameter (inches) 2  
(2) total depth (feet) 190  
(3) static water level (feet) 11 below  
top of ground.

(4) casing galv. 185'  
(material) (depth)  
2" if telescope see back.  
(size)

(5) screen 5' 185'  
(length) (depth to top)  
2" Stainless Steel  
(size) (material)

(6) pump unknown  
(HP) (yield gpm)  
(type power)

(7) electric log no  
(yes or no)  
(organization running log)


(8) how well bottom plugged BP Valve

description of formations  
encountered

from to

Clay	0	8
Sand	8	15
Clay	15	23
Sand	23	30
Clay	30	173
Sand	173	190

CODED

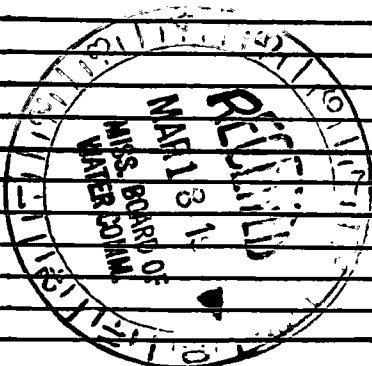

DRILLERS REMARKS:

If well telescopes please sketch and show depths.

GROUND LEVEL

		X	

SECTION 33

Please indicate well location X.

ADDITIONAL INFORMATION

If more than one screen, show locations of each on sketch.