

**MISSISSIPPI
BOARD OF WATER COMMISSIONERS**
416 North State Street
Jackson, Mississippi 39201

CODED

WATER WELL DRILLERS LOG

Harrison
K 72
2-68

Feb 22 1968 M+B Drilling Co. Harrison
date well completed firm name county well located

LANDOWNER: J. B. Ton
R.R. Cullport, Miss.

(mailing address)


WELL LOCATION:
sec. 3 T. 7 S. R. 12 W.
8 miles N of Long Beach
(distance) (direction) (nearest town)

WELL PURPOSE: Farm
(home, irrigation, municipal, industrial)

WELL COMPLETION DATA:

- (1) diameter (inches) 2
- (2) total depth (feet) 575
- (3) static water level (feet) 47 below top of ground.
- (4) casing PVC, 535 (material) (depth)
2" (size) if telescope see back.
- (5) screen 10, 535 (length) (depth to top)
2" (size) PVC Sand Pac. (material)
- (6) pump 1-2 hp, 15 (HP) (yield gpm)
110 Volt 1φ (type power)
- (7) electric log No (yes or no)
- (organization running log)
- (8) how well bottom plugged PVC Cap


description of formations encountered	from	to
Varicolor Clay	0	13
Grey Clay	13	18
Blue Clay	18	60
Blue & White Clay	60	110
Light Blue Clay	110	165
Fine Sand & Clay Breaks	165	185
Sand	185	195
Black Clay + Organic Material	195	205
Dark Grey + Black Clay	205	225
Sand & Clay Breaks	225	250
Grey Clay	250	260
Sand & Clay Breaks	260	265
Fine Sand	265	275
Blue Clay	275	325
Sand & Clay Breaks	325	335
Blue Clay	335	368
Sand	368	375
Blue Clay	375	385
Sand	385	390
Blue Clay	390	465
Grey Sand	465	490
Clay	490	495
Sand - Good	495	575
Still cutting good sand when drilling stopped.		
J.B.		
Circulation test 15, 1600 450		

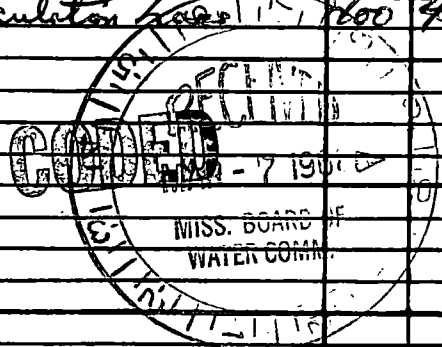

DRILLERS REMARKS:

If well telescopes please sketch and show depths.

GROUND LEVEL

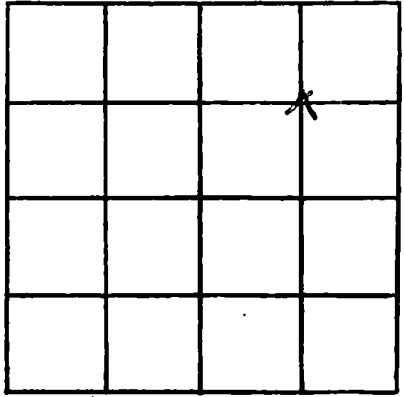

SECTION 3

Please indicate well location X.

ADDITIONAL INFORMATION

Lined area for additional information.

If more than one screen, show locations of each on sketch.