

HARRISON  
K 73  
3-68

MISSISSIPPI  
BOARD OF WATER COMMISSIONERS  
416 North State Street  
Jackson, Mississippi 39201

**CODED**

WATER WELL DRILLERS LOG

3/15 1968 Switzer Well Co. Harrison  
date well/completed firm name county well located

LANDOWNER: Norman Thurt

description of formations encountered	from	to
clay	0	10
sand	10	30
clay	30	42
clay w/sand streaks	42	63
clay	63	146
clay w/sand streaks	146	188
clay	188	198
fair sand	198	206
good sand	206	220

Box 505  
Gulfport, Miss. 39501  
(mailing address)


WELL LOCATION:  
sec. 11 T 2 A R 12 E  
S W  
5 miles NW of GULFPORT  
(distance) (direction) (nearest town)

WELL PURPOSE: Home  
(home, irrigation, municipal, industrial)

WELL COMPLETION DATA:

- (1) diameter (inches) 2
- (2) total depth (feet) 218
- (3) static water level (feet) 26 below above top of ground.
- (4) casing gal. steel, 208' (material) (depth)  
2" If telescope see back. (size)
- (5) screen 10' (length) 208' (depth to top)  
800 (size) 55 on pipe (material)
- (6) pump 3/4 (HP) 600 (yield gpm)  
electric (type power) gpl
- (7) electric log No (yes or no)  
(organization running log)
- (8) how well bottom plugged back pressure valve

**CODED**

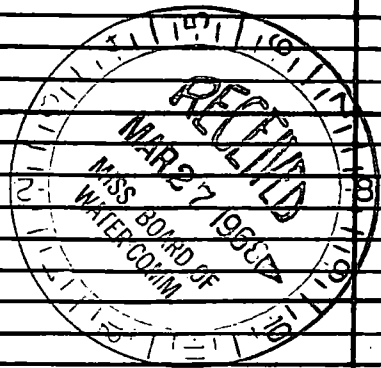

DRILLERS REMARKS: \_\_\_\_\_

If well telescopes please sketch and show depths.

GROUND LEVEL

			X

SECTION 11

Please indicate well location X.

ADDITIONAL INFORMATION

If more than one screen, show locations of each on sketch.