

MISSISSIPPI
BOARD OF WATER COMMISSIONERS
416 North State Street
Jackson, Mississippi 39201

CODED

WATER WELL DRILLERS LOG

HARRISON
K 74
5-68

5-13 1968 *H. B. Anlling Co.* Harrison
date well completed firm name county well located

LANDOWNER: *Jester Powell*
M.R. Long Beach
Miss.
(mailing address)

WELL LOCATION:
sec. *34* T. *7* S. R. *12* E.
2 miles *N* of *Long Beach*
(distance) (direction) (nearest town)

WELL PURPOSE: *Home*
(home, irrigation, municipal, industrial)

- WELL COMPLETION DATA:
- (1) diameter (inches) *2*
 - (2) total depth (feet) *262*
 - (3) static water level (feet) *3* below top of ground.
 - (4) casing *Galv. Steel 232*
(material) (depth) *20 Ft.*
2" If telescope see back. *Tail pipe*
(size)
 - (5) screen *10 Ft., 232*
(length) (depth to top)
2" *S. Steel #1010*
(size) (material) *slot*
 - (6) pump *1* *15*
(HP) (yield gpm)
220 V 1φ
(type power)
 - (7) electric log *No*
(yes or no)

(organization running log)
(8) how well bottom placed *2" Bank*
Wash Valve

DRILLERS REMARKS:


description of formations encountered	from	to
Surface	0	15
Grey Clay	15	18
Sand	18	25
Light Grey Clay	25	40
Sand	40	50
Blue Clay	50	110
Sand	110	114
Blue Clay	114	150
Sea shells, Sand Clay	150	160
Blue Clay	160	200
Fine Sand	200	210
Blue Clay	210	222
Sand	222	242
Blue Clay	242	248
Sand	248	260
Blue Clay	260	262

CODED

MAY 27 1968
MISS. BOARD OF
WATER COMMISSIONERS

If well telescopes please sketch and show depths.

GROUND LEVEL

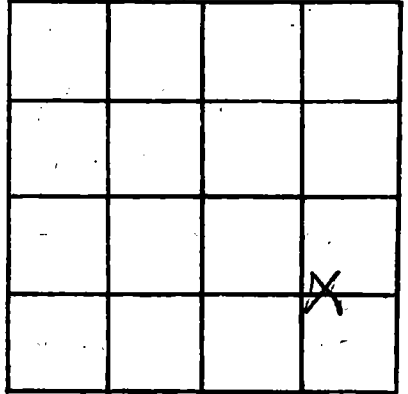

SECTION 34

Please indicate well location X.

ADDITIONAL INFORMATION

Lined area for additional information.

If more than one screen, show locations of each on sketch.