

Harrison  
 K 76  
 8-68

MISSISSIPPI  
 BOARD OF WATER COMMISSIONERS  
 416 North State Street  
 Jackson, Mississippi 39201

**CODED**

WATER WELL DRILLERS LOG

8-2-1968 date well completed  
 Lutter Well Works firm name  
 Harrison county well located

LANDOWNER: Harry C Wood

description of formations encountered	from	to
Clay	0	17
sand	17	23
Clay	23	100
sand	100	205
Clay	205	220
sand	220	241

Rt 1 Box 511

Greepert Driss  
 (mailing address)


WELL LOCATION:  
 sec. 13 T. 7 R. 12  
 S. W. E.  
4 miles NW of Lpt.  
 (distance) (direction) (nearest town)

WELL PURPOSE: Home  
 (home, irrigation, municipal, industrial)

WELL COMPLETION DATA:

- (1) diameter (inches) 2
- (2) total depth (feet) 241
- (3) static water level (feet) 21 below top of ground.
- (4) casing Galv. 231'  
 (material) (depth)  
2" If telescope see back.  
 (size)
- (5) screen 10' 231'  
 (length) (depth to top)  
2" stainless steel  
 (size) (material)
- (6) pump 1/2 10  
 (HP) (yield gpm)  
elec  
 (type power)
- (7) electric log no  
 (yes or no)  
 (organization running log)
- (8) how well bottom plugged BPT value


**CODED**

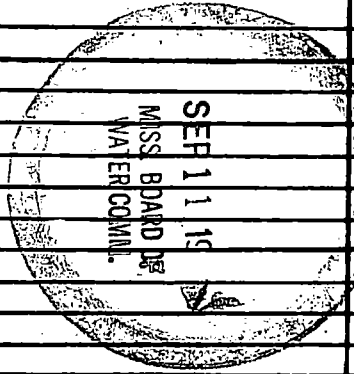

DRILLERS REMARKS:

If well telescopes please sketch and show depths.

GROUND LEVEL

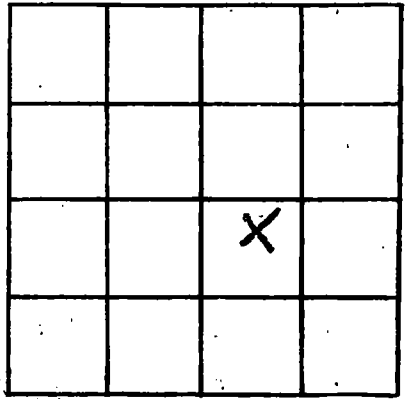

SECTION 13

Please indicate well location X.

ADDITIONAL INFORMATION

If more than one screen, show locations of each on sketch.