

Right on 4- corners rd.  
off Landon Rd 3/4 mi. out.

Harrison  
K 78  
4-68 **CODED**

MISSISSIPPI  
BOARD OF WATER COMMISSIONERS  
416 North State Street  
Jackson, Mississippi 39201  
WATER WELL DRILLERS LOG

**CODED**

4-24 1968 Switzer Well Co. Harrison  
date well completed firm name county well located


LANDOWNER: <u>Charles Harold</u>	description of formations encountered	from	to
<u>Four Corners Road</u> <u>Gulfport, Miss.</u> (mailing address)			
WELL LOCATION: sec. <u>9</u> T. <u>7</u> R. <u>12</u> S. W	<u>Mixed</u>	<u>0</u>	<u>22</u>
<u>12</u> miles <u>NW</u> of <u>GULFPORT</u> (distance) (direction) (nearest town)	<u>Clay</u>	<u>22</u>	<u>83</u>
WELL PURPOSE: <u>Home</u> (home, irrigation, municipal, industrial)	<u>Mixed</u>	<u>83</u>	<u>165</u>
WELL COMPLETION DATA:	<u>Fine sand</u>	<u>165</u>	<u>185</u>
(1) diameter (inches) <u>2</u>	<u>Sand</u>	<u>185</u>	<u>195</u>
(2) total depth (feet) <u>544</u>	<u>Clay</u>	<u>195</u>	<u>205</u>
(3) static water level (feet) <u>36</u> below above top of ground.	<u>Mixed</u>	<u>205</u>	<u>227</u>
(4) casing <u>gal. steel 534'</u> (material) (depth)	<u>Clay</u>	<u>227</u>	<u>248</u>
<u>2"</u> if telescope see back. (size)	<u>Mixed</u>	<u>248</u>	<u>269</u>
(5) screen <u>10'</u> , <u>534'</u> (length) (depth to top)	<u>Clay</u>	<u>269</u>	<u>327</u>
<u>8 in.</u> , <u>SS on pipe</u> (size) (material)	<u>Mixed</u>	<u>327</u>	<u>367</u>
(6) pump <u>not installed</u> (HP) (yield gpm)	<u>Clay</u>	<u>367</u>	<u>413</u>
<u>electric</u> (type power)	<u>Fine sand</u>	<u>413</u>	<u>429</u>
(7) electric log <u>No</u> (yes or no)	<u>Sand</u>	<u>429</u>	<u>433</u>
(organization running log)	<u>Clay</u>	<u>433</u>	<u>437</u>
(8) how well bottom plugged <u>Back</u> <u>pressure valve</u>	<u>Fine sand</u>	<u>437</u>	<u>491</u>
DRILLERS REMARKS:	<u>Good sand</u>	<u>491</u>	<u>544</u>

**CODED**

MISSISSIPPI  
BOARD OF WATER COMMISSIONERS

If well telescopes please sketch and show depths.

GROUND LEVEL

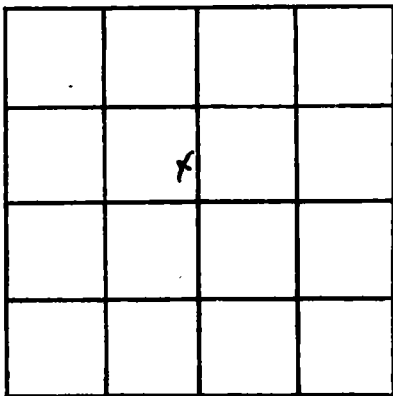

SECTION 9

Please indicate well location X.

ADDITIONAL INFORMATION

If more than one screen, show locations of each on sketch.