

Harrison
K79
4-68

MISSISSIPPI
BOARD OF WATER COMMISSIONERS
416 North State Street
Jackson, Mississippi 39201

CODED

WATER WELL DRILLERS LOG

4-4 1968 Pineville Water Works Harrison
date well completed firm name county well located

LANDOWNER: Joe Sumrell
Rt. # 1
Lory Beach, Miss.
(mailing address)

description of formations encountered	from	to
hard clay	0	5'
Red Clay & gravel	5	35
app 5 ft per gravel	35	280
	280	285
Hard blue clay	285	400
med water sand all the way very coarse	400	465

WELL LOCATION:
sec. 33 T. 7 N. R. 12 E.
5 miles (distance) N 92 W (direction) of Lory Beach (nearest town)

WELL PURPOSE:
(home, irrigation, municipal, industrial)

WELL COMPLETION DATA:


- (1) diameter (inches) 2"
- (2) total depth (feet) 465'
- (3) static water level (feet) 4-1" below top of ground
- (4) casing galv (material) 445' (depth)
- none (size) if telescope see back.
- (5) screen 20' (length) 445' (depth to top)
2" (size) D.S. on gal (material)
- (6) pump 2 (HP) 60 (yield gpm)
Elec (type power)
- (7) electric log none (yes or no)
none (organization running log)
- (8) how well bottom plugged 2" B.W.
value

CODED

CODED

is this well
the gal 2" dia
line from well to
pump; pump w/ 2"
Dric line main
at end of 28 ft.

DRILLERS REMARKS: This well is to furnish 20 hard feet

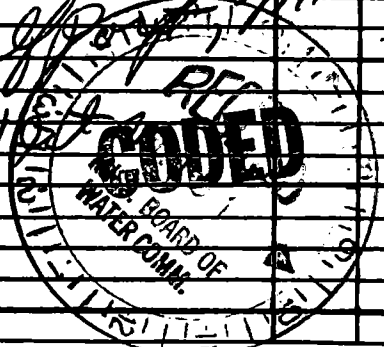

If well telescopes please sketch and show depths.

GROUND LEVEL

SECTION _____

Please indicate well location X:

ADDITIONAL INFORMATION

If more than one screen, show locations of each on sketch.