

CODED

MISSISSIPPI
BOARD OF WATER COMMISSIONERS
416 North State Street
Jackson, Mississippi 39201

WATER WELL DRILLERS LOG

Harrison
K 82
9-9-68

9-9 1968 Grinnell Water Works Harrison
date well completed firm name county well located

LANDOWNER: Wiggins
Rt 1 Wolf River
Paso Christian Miss.
(mailing address)

| description of formations encountered | from | to |
|---|------------|------------|
| <u>sandy soil</u> | <u>0</u> | <u>90</u> |
| <u>sand & water gravel</u> | <u>90</u> | <u>150</u> |
| <u>Blue Clay or mud</u> | <u>130</u> | <u>180</u> |
| <u>Cone water sand & Blue gray gravel</u> | <u>180</u> | <u>218</u> |

WELL LOCATION:
sec 32 T 7 N R 12 E
9 miles East of Behle
(distance) (direction) (nearest town)

WELL PURPOSE: Home
(home, irrigation, municipal, industrial)

WELL COMPLETION DATA:

- (1) diameter (inches) 2"
- (2) total depth (feet) 218
- (3) static water level (feet) 3 below above
top of ground.
- (4) casing gal pipe, 208
(material) (depth)
- If telescope see back.
(size)
- (5) screen 10ft, 208
(length) (depth to top)
2", S.S. screen
(size) (material)
- (6) pump 1/2 950hp
(HP) (yield gpm)
Elec.
(type power)
- (7) electric log no
(yes or no)
none
(organization running log)
- (8) how well bottom plugged 2" spring
Bob Work Valve

CODED


MISS. BD. OF
WATER COM.

10 1968

DRILLERS REMARKS:

If well telescopes please sketch and show depths.

GROUND LEVEL

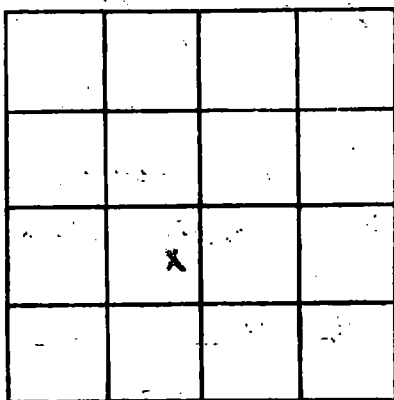

SECTION 32

Please indicate well location X.

ADDITIONAL INFORMATION

If more than one screen, show locations of each on sketch.