

Harrison
R 84
11-1-68

MISSISSIPPI
BOARD OF WATER COMMISSIONERS
416 North State Street
Jackson, Mississippi 39201

CODÉD

WATER WELL DRILLERS LOG

Nov. 1 1968 date well completed
Ladner's Industrial Harrison firm name
Harrison county well located

LANDOWNER: James Nobles

description of formations encountered	from	to
<u>yellow clay</u>	<u>20 feet</u>	
<u>white sand</u>	<u>80 feet</u>	
<u>Blue clay</u>	<u>170 feet</u>	
<u>Blue sand</u>	<u>17 feet</u>	

Quailan Long Beach
(mailing address) Miss

WELL LOCATION:
sec. 33 T. 9 N. R. 12 E.
1 1/2 miles north of Long Beach
(distance) (direction) (nearest town)

WELL PURPOSE: home
(home, irrigation, municipal, industrial)

WELL COMPLETION DATA:

- (1) diameter (inches) 2 inch
- (2) total depth (feet) 297
- (3) static water level (feet) 12 ft below top of ground.
- (4) casing Gal. 287
(material) (depth)
2 inch if telescope see back.
(size)
- (5) screen 10 ft. 287
(length) (depth to top)
2 inch Stainless Steel
(size) (material)
- (6) pump 1/2 10
(HP) (yield gpm)
Electric
(type power)
- (7) electric log no
(yes or no)

CODÉD

(organization running log)

(8) how well bottom plugged Ball Check


DRILLERS REMARKS:

MISS. BD. OF
WATER COMMISSIONERS

1969

If well telescopes please sketch and show depths.

GROUND LEVEL

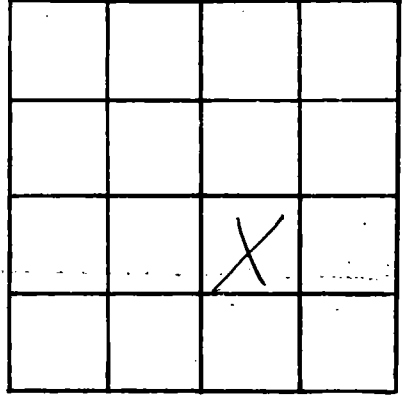

SECTION 33

Please indicate well location X.

ADDITIONAL INFORMATION

If more than one screen, show locations of each on sketch.