

Harrison  
K 85  
11-13-68

MISSISSIPPI  
BOARD OF WATER COMMISSIONERS  
416 North State Street  
Jackson, Mississippi 39201

**CODED**

WATER WELL DRILLERS LOG

Nov. 13 1968 date well completed  
Ladnier Well Works firm name  
Harrison county well located

LANDOWNER: Council  
Ladnier  
Mitchell Road, L.B.  
(mailing address)

WELL LOCATION:  
sec. 35 T 7 S R 12 E  
3 miles North West of Long Beach  
(distance) (direction) (nearest town)

WELL PURPOSE: Home  
(home, irrigation, municipal, industrial)

- WELL COMPLETION DATA:
- (1) diameter (inches) 2 inch
  - (2) total depth (feet) 580
  - (3) static water level (feet) 15 below top of ground
  - (4) casing Gal. 565 (material) (depth)  
2 inch (size) if telescope see back.
  - (5) screen 15 (length) 565 (depth to top)  
2 inch (size) Stainless steel (material)
  - (6) pump 1 Horse (HP) 12 (yield gpm)  
Electric (type power)
  - (7) electric log no (yes or no)
  - (organization running log)
  - (8) how well bottom plugged Ball Check

description of formations encountered	from	to
yellow clay	30	40
white sand	60	70
yellow clay	70	80
yellow sand	80	90
blue clay	100	110
blue sand	150	160


**CODED**

DRILLERS REMARKS:

NOV 13 1968

If well telescopes please sketch and show depths.

GROUND LEVEL

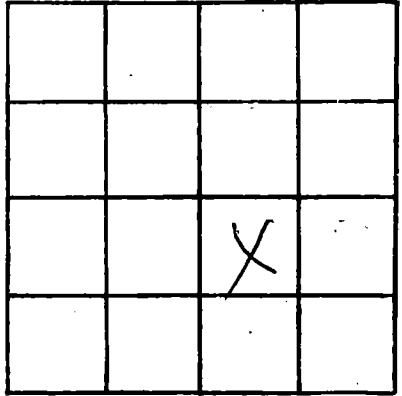

SECTION 35

Please indicate well location X.

ADDITIONAL INFORMATION

If more than one screen, show locations of each on sketch.