

Harrison
K 93
3-16-70

MISSISSIPPI
BOARD OF WATER COMMISSIONERS
416 North State Street
Jackson, Mississippi 39201

CODED

WATER WELL DRILLERS LOG

3-16 1970 R. J. MOORE HARRISON
date well completed firm name county well located

LANDOWNER: <u>H. A. HUFFMAN</u>	description of formations encountered	from	to
<u>RT. 2 329 Box</u>	<u>TOP SOIL</u>	<u>0</u>	<u>10</u>
<u>GULF PORT MISS</u> (mailing address)	<u>Red SAND</u>	<u>10</u>	<u>30</u>
	<u>Red + White CLAY</u>	<u>30</u>	<u>72</u>
	<u>Red SAND</u>	<u>77</u>	<u>93</u>
	<u>BLUE CLAY</u>	<u>93</u>	<u>282</u>
	<u>FINE BLUE SAND</u>	<u>282</u>	<u>300</u>
	<u>BLUE CLAY</u>	<u>300</u>	<u>461</u>
	<u>FINE SAND</u>	<u>461</u>	<u>482</u>
	<u>Med Grey SAND</u>	<u>482</u>	<u>515</u>

WELL LOCATION:
sec 9 T 7 N R 12 E
6 miles West of LANDON
(distance) (direction) (nearest town)

WELL PURPOSE:
(home, irrigation, municipal, industrial)

- WELL COMPLETION DATA:
- (1) diameter (inches) 2"
 - (2) total depth (feet) 515'
 - (3) static water level (feet) 18 ^{below}/_{above} top of ground
 - (4) casing GALV 500'
(material) (depth)
 - (size) if telescope see back.
 - (5) screen 2X10 500'
(length) (depth to top)
 - 2" SS
(size) (material)
 - (6) pump 1 640 hr
(HP) (yield gpm)
 - Elec
(type power)
 - (7) electric log
(yes or no)

(organization running log)

(8) how well bottom plugged BW
VALVE

DRILLERS REMARKS:


CODED

APR - 8 1970

MISS. BD. OF
WATER COMM.

If well telescopes please sketch and show depths.

GROUND LEVEL

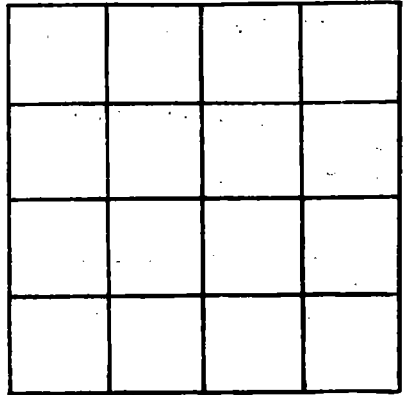

SECTION _____

Please indicate well location X.

ADDITIONAL INFORMATION

If more than one screen, show locations of each on sketch.