

Harrison
K 95
5-21-70

MISSISSIPPI
 BOARD OF WATER COMMISSIONERS
 416 North State Street
 Jackson, Mississippi 39201

CODED

WATER WELL DRILLERS LOG

5-21 1970 R.J. MOORE HARRISON
 date well completed firm name county well located


LANDOWNER: <u>M. H. STUBBS</u>	description of formations encountered	from	to
<u>RT. 1 Box 447</u>	<u>TOP SOIL</u>	<u>0</u>	<u>10</u>
<u>GULFPORT MISS</u> (mailing address)	<u>White Sand</u>	<u>10</u>	<u>30</u>
WELL LOCATION: <u>18'</u>	<u>Blue to white Clay</u>	<u>30</u>	<u>62</u>
sec. <u>13</u> T. <u>7</u> N. R. <u>12</u> E	<u>Blue Clay</u>	<u>62</u>	<u>167</u>
_____ miles _____ of _____ (distance) (direction) (nearest town)	<u>Rusty Sand</u>	<u>167</u>	<u>249</u>
WELL PURPOSE: (home, irrigation, municipal, industrial)			
WELL COMPLETION DATA:			
(1) diameter (inches) <u>2"</u>			
(2) total depth (feet) <u>249'</u>			
(3) static water level (feet) <u>28'</u> <u>below</u> above top of ground.			
(4) casing <u>galv</u> <u>249'</u> (material) (depth)			
_____ if telescope see back. (size)			
(5) screen <u>240</u> <u>209</u> (length) (depth to top)			
<u>2"</u> <u>SS</u> (size) (material)			
(6) pump <u>1</u> <u>20 GPM</u> (HP) (yield gpm)			
<u>plac</u> (type power)			
(7) electric log _____ (yes or no)			
_____ (organization running log)			
(8) how well bottom plugged <u>BW</u> <u>1964</u>			
DRILLERS REMARKS:			

JUN 4 1970

MISS. BD. OF
 WATER COM.

If well telescopes please sketch and show depths.

GROUND LEVEL

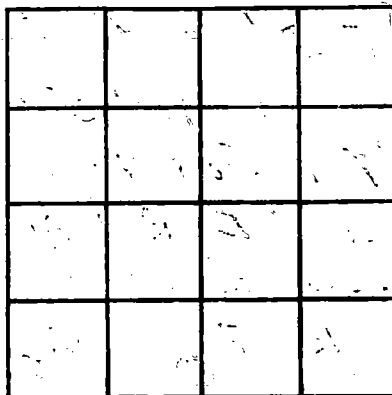

SECTION _____

Please indicate well location X.

ADDITIONAL INFORMATION

If more than one screen, show locations of each on sketch.