

Harrison
K96
5-29-70

MISSISSIPPI
BOARD OF WATER COMMISSIONERS
416 North State Street
Jackson, Mississippi 39201
WATER WELL DRILLERS LOG

CODED

5-29 1970 R. J. MOORE HARRISON
date well completed firm name county well located

LANDOWNER: L. ASHER
LORA DRIVE 28th STREET
GULF PORT, MISS.
(mailing address)

description of formations encountered	from	to
TOP SOIL	0	10
White Sand	10	18
Blue + white Clay	18	20
Blue SILT	20	24
Blue Clay	24	120
Blue Sand FINE	120	125
Blue Clay	125	188
Grey Sand	188	200

WELL LOCATION:
sec. 36 T 7 N R 12 E 188
4 miles NORTH of LONG BEACH
(distance) (direction) (nearest town)

WELL PURPOSE:
(home, irrigation, municipal, industrial)

- WELL COMPLETION DATA:
- (1) diameter (inches) 2"
 - (2) total depth (feet) 200'
 - (3) static water level (feet) 19' ^{below} above top of ground.
 - (4) casing 2440 190'
(material) (depth)
 If telescope see back.
(size)
 - (5) screen 2x10 190'
(length) (depth to top)
2" SS
(size) (material)
 - (6) pump 1 620 GPM
(HP) (yield gpm)
8
(type power)
 - (7) electric log
(yes or no)

(organization running log)
 - (8) how well bottom plugged BW
valve


DRILLERS REMARKS:

JUN 4 1970

MISS. Bd. of WATER COMMISSIONERS

If well telescopes please sketch and show depths.

GROUND LEVEL

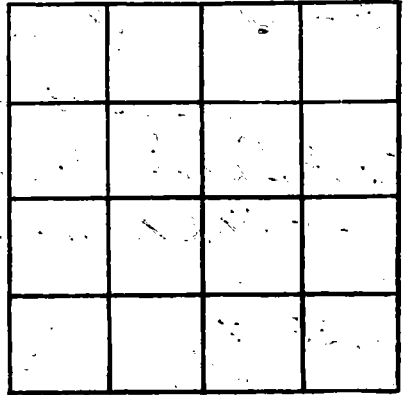

SECTION _____

Please indicate well location X.

ADDITIONAL INFORMATION

If more than one screen, show locations of each on sketch.