

**Harrison**  
**K 97**  
**5-28-70**

MISSISSIPPI  
 BOARD OF WATER COMMISSIONERS  
 416 North State Street  
 Jackson, Mississippi 39201

**CODED**

**3** **BD WATER WELL DRILLERS LOG**

5/28 1970 Coastal Drilling Harrison  
 date well completed firm name county well located

LANDOWNER: Clay Adams  
Rt 3 Box 340  
Gupton Miss  
 (mailing address)

description of formations encountered	from	to
<u>top soil</u>	<u>6</u>	<u>5</u>
<u>white sand</u>	<u>60</u>	<u>60</u>
<u>Blue Clay</u>	<u>60</u>	<u>120</u>
<u>fine white sand</u>	<u>120</u>	<u>180</u>
<u>Coarse white sand</u>	<u>180</u>	<u>216</u>

WELL LOCATION:  
 sec. 12 T 2 R 13 209  
3 miles NE of Jordan  
 (distance) (direction) (nearest town)

WELL PURPOSE: home  
 (home, irrigation, municipal, industrial)

WELL COMPLETION DATA:

(1) diameter (inches) 2"

(2) total depth (feet) 216

(3) static water level (feet) 18 below above top of ground

(4) casing glau 206  
 (material) (depth)

(size) if telescope see back.

(5) screen 10' 206  
 (length) (depth to top)

2" SS  
 (size) (material)

(6) pump 1/2HP 14  
 (HP) (yield gpm)

Ell  
 (type power)

(7) electric log no  
 (yes or no)

(organization running log)

(8) how well bottom plugged  
2' back with sand


DRILLERS REMARKS:  
none

JUN 11 1970

MISS. BD. OF  
 WATER

If well telescopes please sketch and show depths.

GROUND LEVEL

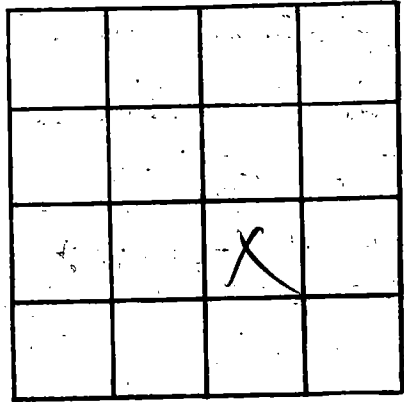

SECTION \_\_\_\_\_

Please indicate well location X.

ADDITIONAL INFORMATION

Lined area for additional information.

If more than one screen, show locations of each on sketch.