

HARRISON
K 98
9-11-70

MISSISSIPPI
BOARD OF WATER COMMISSIONERS
416 North State Street
Jackson, Mississippi 39201

CODED

WATER WELL DRILLERS LOG

9-11 1970 R. J. MOORE HARRISON
date well completed firm name county well located

LANDOWNER: C. N. BRAGG
Rt 1 Box 612 X
Dyersburg Miss.
(mailing address)

description of formations encountered	from	to
TOP SOIL	0	10
meadow sand	10	20
Grey Gumbo	20	100
Blue clay	100	160
FINE sand	160	205
Blue clay	205	220
Blue sand	220	248

WELL LOCATION:
sec. 34 T 2 N R. 12 E
4 miles N of LONG BEACH
(distance) (direction) (nearest town)

WELL PURPOSE:
(home, irrigation, municipal, industrial)

WELL COMPLETION DATA:

(1) diameter (inches) 2"

(2) total depth (feet) 240'

(3) static water level (feet) 6' ^{below} above top of ground.

(4) casing 2 1/2" (material) 230' (depth)

_____ If telescope see back. (size)

(5) screen 2x10 (length) 230' (depth to top)

2" (size) SS (material)

(6) pump 1 (HP) 200 GPM (yield gpm)

Elc (type power)

(7) electric log _____ (yes or no)

_____ (organization running log)

(8) how well bottom plugged BW
none


CODED

DRILLERS REMARKS:

SEP 21 1970

If well telescopes please sketch and show depths.

GROUND LEVEL

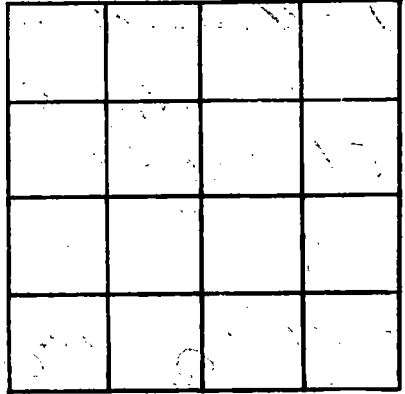

SECTION _____

Please indicate well location X.

ADDITIONAL INFORMATION

If more than one screen, show locations of each on sketch.