

Harrison
K101
2-19-69

MISSISSIPPI
 BOARD OF WATER COMMISSIONERS
 416 North State Street
 Jackson, Mississippi 39201

CODED

WATER WELL DRILLERS LOG

FEB 19 1969 MCGILL HARRISON
 date well completed firm name county well located

LANDOWNER: LUTHER
HUGHES
RT1 BOX 624 e
GUIFPART (mailing address)

description of formations encountered	from	to
<u>TOP SOIL</u>	<u>0</u>	<u>10</u>
<u>CLAY</u>	<u>10</u>	<u>105</u>
<u>SAND</u>	<u>105</u>	<u>125</u>

WELL LOCATION:
 sec. 33 T 7 N R 12 E
4 miles N of Long Beach
 (distance) (direction) (nearest town)

WELL PURPOSE: HOME
 (home, irrigation, municipal, industrial)

WELL COMPLETION DATA: 1

(1) diameter (inches) 1 1/4

(2) total depth (feet) 125

(3) static water level (feet) 6 below
 top of ground.

(4) casing none
 (material) (depth)

none if telescope see back.
 (size)

(5) screen 5 120
 (length) (depth to top)

1 1/4 SS
 (size) (material)

(6) pump none
 (HP) (yield gpm)

none
 (type power)

(7) electric log no
 (yes or no)

AW
 (organization running log)

(8) how well bottom plugged AW

CODED


JUN 30 1969

MISS. BD. OF
 WATER COMM.

DRILLERS REMARKS:

If well telescopes please sketch and show depths.

GROUND LEVEL

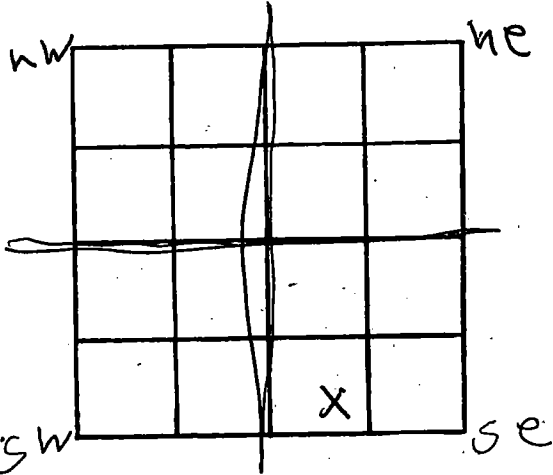

SECTION 33

Please indicate well location X.

ADDITIONAL INFORMATION

If more than one screen, show locations of each on sketch.