

HARRISON  
K105  
6-2-70

MISSISSIPPI  
BOARD OF WATER COMMISSIONERS  
416 North State Street  
Jackson, Mississippi 39201

**CODED**

*Letter requesting info*

WATER WELL DRILLERS LOG

June 2 1970 McGill Well Works HARRISON  
date well completed firm name county well located

LANDOWNER: Chester  
Whisenant  
Bulport Miss  
(mailing address)

WELL LOCATION:  
sec. 33 T. 07 N. R. 12 E  
6 miles <sup>S</sup> 7W of Bay Beach  
(distance) (direction) (nearest town)

description of formations encountered	from	to
<u>top soil</u>	<u>0'</u>	<u>10'</u>
<u>clay</u>	<u>10'</u>	<u>135'</u>
<u>sand</u>	<u>135'</u>	<u>150'</u>

WELL PURPOSE: HOME  
(home, irrigation, municipal, industrial)

WELL COMPLETION DATA:

(1) diameter (inches) 2"

(2) total depth (feet) 150'

(3) static water level (feet) 8' below above top of ground.

(4) casing gal - ?  
(material) (depth)

- If telescope see back.  
(size)

(5) screen 10', 140  
(length) (depth to top)

9", S.S.  
(size) (material)

(6) pump 1 12  
(HP) (yield gpm)

Electric  
(type power)

(7) electric log - 0  
(yes or no)

(organization running log)

(8) how well bottom plugged Sand  
SMRK


**CODED**

DRILLERS REMARKS: AUG 14 1970

MISS. NO. OF  
ATER COMM.

If well telescopes please sketch and show depths.

GROUND LEVEL

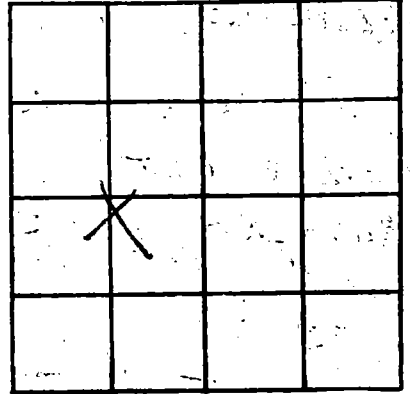

SECTION 33

Please indicate well location X.

ADDITIONAL INFORMATION

If more than one screen, show locations of each on sketch.