

HAR. MISSISSIPPI BOARD OF WATER COMMISSIONERS

① K108
7-20-63

9320 506
WATER WELL DRILLERS LOG

CODED

Date: July 20, 1963, Driller: Joe Miller County Harrison
(Name)

(1) Owner of Land: Mitchel Reyer
(Name)
RR#1 Box 621 Gulfport Miss
(Address)

(2) Location: 3 1/2 miles W of Gulfport
(distance) (direction) (Nearest Town)
3 1/2 Sec. 7 T. 12 R.

(3) Topography: Flat
(Hilly) (Flat) (Level)

(4) Purpose of Well: Domestic
(Domestic Irrigation
Municipal, Industrial, Other)

Description & Color of Materials Sand, Clay, Red Clay, Shell, etc.	Thick- ness Feet	Depth Feet
Red Clay	8	8
Wh Sand	4	12
Wh Sand & Wood	2	14
Blue Clay	186	200
Sand & Clay Mix	20	220
Sand, Gray, (Fine)	11	231
Sand, Clay Wood	10	241
Soft Blue Clay	31	272
Hard Blue Clay	213	485
Sand, Gray, Fine	16	501
Sand .. Good	11	512
1' Hard Blue Clay	20	526
	4	530

Information upon completion of well:

(1) Diameter 2" inches.

(2) Total Depth 530' feet.

(3) Water Level Flowing feet below top of ground.

(4) Cased to 516, Size 2"

(5) Screen: Size 2", Length 10'
4" Jaul Pipe


(6) Were any formations sealed against pollution?
_____ yes, _____ no.

If YES depth of formation _____

Why _____

Drillers Remarks: _____

CODED

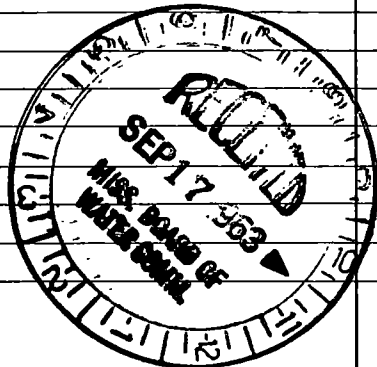

(Use Back Side)

Well No.

1911

Washington, D.C.

My dear Mr. [Name]:

I have just received your letter of the 10th and am glad to hear from you. I am sorry that I cannot give you a more definite answer at this time, but I am sure that you will understand my position.

I am sure that you will understand my position.

I am sure that you will understand my position.

