

DK107

5-6-66

WATER WELL DRILLERS LOG

CODED

Date: 5-6, 1966, Driller: Hattisburg Butrus County Jackson
(Name)


	Description & Color of Materials Sand, Clay, Red Clay, Shell, etc.	Thick- ness Feet	Depth Feet
(1) Owner of Land: <u>Harry T. Davis</u> (Name)	<u>yellow clay</u>	<u>1-</u>	<u>8</u>
Support, <u>Trues</u> (Address)	<u>gravel</u>	<u>8-</u>	<u>15</u>
(2) Location: <u>1/4, 1/4, Sec. T. R.</u> <u>Landon Rd.</u>	<u>Blue clay</u>	<u>15-</u>	<u>135</u>
_____ miles _____ of _____ (distance) (direction) (Nearest Town)	<u>Blue sand</u>	<u>135-</u>	<u>150</u>
(3) Topography: <u>X</u> (Hilly) (Flat) (Level)			
(4) Purpose of Well: <u>domestic</u> (Domestic Irrigation Municipal, Industrial, Other)			

Information upon completion of well:

- (1) Diameter 2 inches.
- (2) Total Depth 150 feet.
- (3) Water Level 15 feet below top of ground.
- (4) Cased to _____, Size _____
- (5) Screen: Size 2", Length 10'
- (6) Were any formations sealed against pollution?
_____ yes, X no.

If YES depth of formation _____
Why _____
Drillers Remarks: _____

CODED

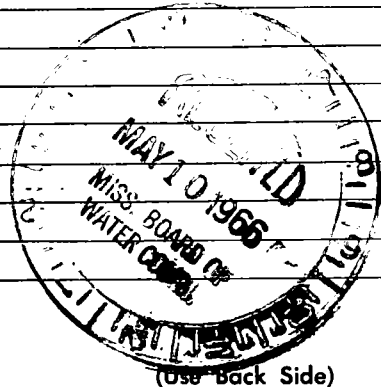

(Use Back Side)

Well No.

1000