

K 109

3-15-65

WATER WELL DRILLERS LOG

**CODED**

Date: Nov 15, 1963, Driller: Joe Miller County Harrison

(Name)

(1) Owner of Land: William Gnile  
(Name)  
RR# Smith Rd - Gulfport  
(Address)

(2) Location: 3/4, 1/4, Sec. 7 R  
 \_\_\_\_\_ miles \_\_\_\_\_ of \_\_\_\_\_  
(distance) (direction) (Nearest Town)

(3) Topography: Flat  
(Hilly) (Flat) (Level)

(4) Purpose of Well: Domestic  
(Domestic Irrigation Municipal, Industrial, Other)

Description & Color of Materials Sand, Clay, Red Clay, Shell, etc.	Thick- ness Feet	Depth Feet
Fill	1	1
Wh + Br Clay	7	8
Black Clay	4	12
Fine Sand	3	15
Blue Clay	55	70
Blue Sand (Fine)	13	83
Blue Clay	162	195
Blue Sand (Fine)	10	205
Hd Blo Clay	10	215
Gray Sand (Fine)	23	238
Hard Blue Clay	46	284
Gray Sand	7	291
Hard Blu Clay	94	385
Gray Sand (Fine)	15	400
" " Better	11	411
" " Good	5	416
Hard Blue Clay	4	420

Information upon completion of well:

(1) Diameter 2" inches.

(2) Total Depth 420 feet.

(3) Water Level Top Ground feet below top of ground.

(4) Cased to 406', Size 2"


(5) Screen: Size 2", Length 10'

(6) Were any formations sealed against pollution?  
 \_\_\_\_\_ yes, \_\_\_\_\_ no.

If YES depth of formation \_\_\_\_\_

Why \_\_\_\_\_

Drillers Remarks: \_\_\_\_\_

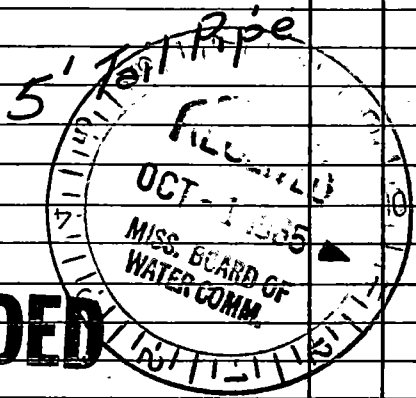

**CODED**

(Use Back Side)

Well No.

11/15/2014  
11/15/2014  
11/15/2014

Gulfport

S

28th St.

Watts  
Riv

W

Smith Rd

Wilson Bridge

NKY 49

N

W

