

HARRISON
K 116
1-29-71

MISSISSIPPI
 BOARD OF WATER COMMISSIONERS
 416 North State Street
 Jackson, Mississippi 39201

CODED

WATER WELL DRILLERS LOG

Jan. 29 1971 Salmeri Well Works Harrison
 (date well completed) (firm name) (county well located)

LANDOWNER: Joseph Parker
West 28th Street
Gulfport Miss.
 (mailing address)

description of formations encountered	from	to
<u>yellow clay + sand</u>	<u>0</u>	<u>60</u>
<u>Blue clay</u>	<u>60</u>	<u>307</u>
<u>Blue sand</u>	<u>307</u>	<u>427</u>

WELL LOCATION:
 sec. 33 T. 7 N. R. 12 E.
3 miles N Long Beach
 (distance) (direction) (nearest town)

WELL PURPOSE: Home
 (home, irrigation, municipal, industrial)

WELL COMPLETION DATA:

(1) diameter (inches) 2 inch

(2) total depth (feet) 427 feet

(3) static water level (feet) 12 ft ^(below) above top of ground.

(4) casing Dalu, 417 ft.
 (material) (depth)
2 inch (size) if telescope see back.

(5) screen 10 ft, 417 ft.
 (length) (depth to top)
2 inch, 5.5.
 (size) (material)

(6) pump 1/2, 8.
 (HP) (yield gpm)
Elec.
 (type power)

(7) electric log no.
 (yes or no)

(organization running log)

(8) how well bottom plugged Ball Check

CODED


JUL 21 1971

DRILLERS REMARKS:

MISS. Bd. OF
 WATER COM.

If well telescopes please sketch and show depths.

GROUND LEVEL

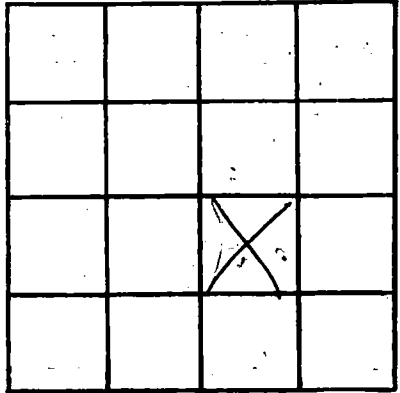

SECTION 33

Please indicate well location X.

ADDITIONAL INFORMATION

If more than one screen, show locations of each on sketch.