

CODED

~~AK 126N~~
10-15-60

WATER WELL DRILLERS LOG

Date: 10-15, 1960, Driller: M'brg Butane County Harrison
(Name)

(1) Owner of Land: Shirley Cuevas
(Name)
Rt 1 Box 217, Pass Christian
(Address)
34 7 12
(2) Location: 1/4, 1/4, Sec. T R
_____ miles _____ of _____
(distance) (direction) (Nearest Town)

(3) Topography: _____
(Hilly) (Flat) (Level)

(4) Purpose of Well: domestic
(Domestic Irrigation
Municipal, Industrial, Other)


Description & Color of Materials Sand, Clay, Red Clay, Shell, etc.	Thick- ness Feet	Depth Feet
Red sand	0-	20
" clay	20-	75
" sand	75-	90
white clay	90-	140
" sand	140-	173

Information upon completion of well:

(1) Diameter 2 inches.
(2) Total Depth 173 feet.
(3) Water Level 54 feet below top of ground.
(4) Cased to _____, Size _____
(5) Screen: Size 2", Length 10'
(6) Were any formations sealed against pollution?
_____ yes, X no.

CODED

If YES depth of formation _____
Why _____
Drillers Remarks: _____

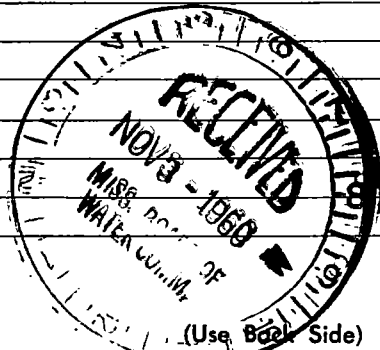

Well No.

1000

1000

1000

