

HARRISON
K 128
11-19-71

MISSISSIPPI
 BOARD OF WATER COMMISSIONERS
 416 North State Street
 Jackson, Mississippi 39201

WATER WELL DRILLERS LOG

CODED

Nov 19 1971

date well completed

Winnable Water Co

firm name

Harrison

county well located

LANDOWNER: *Trailer Repair*
Log Bay 28 St.
Shppard
 (mailing address)

description of formations encountered

from

to

<i>large gravel</i>	<i>0</i>	<i>45</i>
<i>blue pop clay</i>	<i>45</i>	<i>180</i>
<i>Water sand /</i>	<i>225</i>	<i>257</i>

WELL LOCATION:

sec. 3 T. 7 R. 22
3 miles *W* of *Log Bay*
 (distance) (direction) (nearest town)

WELL PURPOSE: *Municipal*
 (home, irrigation, municipal, industrial)

WELL COMPLETION DATA:


- (1) diameter (inches) *4 X 2*
- (2) total depth (feet) *257 1/4*
- (3) static water level (feet) *2* below top of ground
- (4) casing *PVC*, *257*
 (material) (depth)
- 4 X 2* if telescope see back.
 (size)
- (5) screen *15*, *242*
 (length) (depth to top)
- 2"*, *PVC*
 (size) (material)
- (6) pump *1/2 HP* *WAK*
 (HP) (yield gpm)
- 1/2 HP*
 (type power)
- (7) electric log *NO*
 (yes or no)
- N/A*
 (organization running log)
- (8) how well bottom plugged *sand*
slough sand

CODED

REAVY 25 1971

DRILLERS REMARKS:

If well telescopes please sketch and show depths.

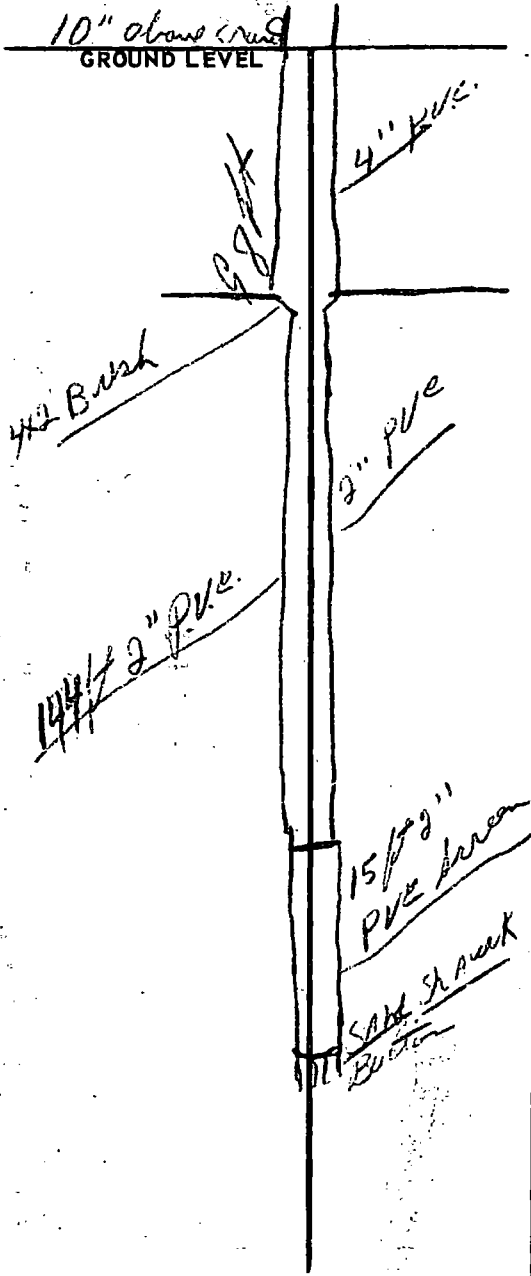

SECTION _____

Please indicate well location X.

ADDITIONAL INFORMATION

If more than one screen, show locations of each on sketch.