

HARRISON
K129
10-21-71

MISSISSIPPI
 BOARD OF WATER COMMISSIONERS
 416 North State Street
 Jackson, Mississippi 39201

CODED

WATER WELL DRILLERS LOG

Oct 21 1971 Penwell Water Well Harrison
 date well completed firm name county well located

LANDOWNER: Mr. Lyle Duffin
28 St
Sulphur Miss
 (mailing address)

description of formations encountered	from	to
<u>Sand & pe gravel</u>	<u>0</u>	<u>45</u>
<u>pprl clay</u>	<u>45</u>	<u>190</u>
<u>Water sand</u>	<u>225</u>	<u>250</u>

WELL LOCATION:
 sec. 3 T. 7 R. 12
3 miles N of Jay Road
 (distance) (direction) (nearest town)

WELL PURPOSE: Home
 (home, irrigation, municipal, industrial)

WELL COMPLETION DATA:

- (1) diameter (inches) 2"
- (2) total depth (feet) 250
- (3) static water level (feet) 24 below above top of ground.
- (4) casing P.V.C. #40 250
 (material) (depth)
 (size) If telescope see back.
- (5) screen 10 1/4 2 1/2
 (length) (depth to top)
3 P.V.C. #40
 (size) (material)
- (6) pump 1/2 10
 (HP) (yield gpm)
Elec.
 (type power)
- (7) electric log no
 (yes or no)
N/A.
 (organization running log)
- (8) how well bottom plugged Sand Shrub

CODED

Count wood
to
25
1972


REV 25 1972

DRILLERS REMARKS:

MISS. BO
 WATER COMM

If well telescopes please sketch and show depths.

GROUND LEVEL

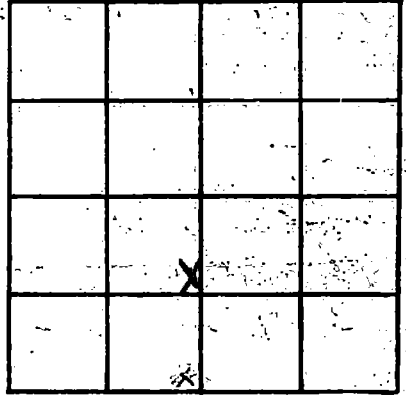

SECTION 3

Please indicate well location X.

ADDITIONAL INFORMATION

If more than one screen, show locations of each on sketch.