

HARRISON
K 133
8-18-72

MISSISSIPPI
 BOARD OF WATER COMMISSIONERS
 416 North State Street
 Jackson, Mississippi 39201

WATER WELL DRILLERS LOG

CODED


August 18, 1972 Ladwies's Well Works HARRISON
 date well completed firm name county well located

LANDOWNER: <u>Mr. Ally</u> <u>Canal Road</u>	description of formations encountered	from	to
<u>Gulfport, Miss.</u> (mailing address)	<u>Yellow Clay</u>	<u>0</u>	<u>30</u>
WELL LOCATION:	<u>White Sand's Gravel</u>	<u>30</u>	<u>80</u>
sec. <u>2</u> T. <u>7</u> R. <u>12</u>	<u>Blue Clay</u>	<u>80</u>	<u>500</u>
<u>4</u> miles <u>North West</u> of <u>Gulfport</u>	<u>Blue Sand</u>	<u>500</u>	<u>537</u>
(distance) (direction) (nearest town)			
WELL PURPOSE: <u>Home</u> (home, irrigation, municipal, industrial)			
WELL COMPLETION DATA:			
(1) diameter (inches) <u>2 inch</u>	CODED		
(2) total depth (feet) <u>547 ft.</u>			
(3) static water level (feet) <u>60</u> below top of ground.			
(4) casing <u>Galv.</u> <u>537 ft.</u> (material) (depth)			
<u>2 inch</u> if telescope see back. (size)			
(5) screen <u>10 ft.</u> <u>537 ft.</u> (length) (depth to top)			
<u>2 inch</u> <u>S.S.</u> (size) (material)			
(6) pump <u>1</u> <u>8</u> (HP) (yield gpm)			
<u>Elect.</u> (type power)			
(7) electric log <u>No</u> (yes or no)			
(organization running log)			
(8) how well bottom plugged <u>Ball Check</u>			
DRILLERS REMARKS:			

NOV 22 1972

If well telescopes please sketch and show depths.

GROUND LEVEL

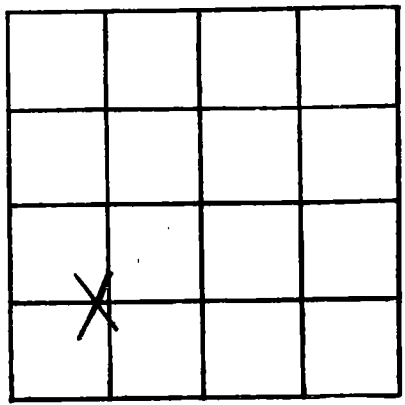

- SECTION 2

Please indicate well location X.

ADDITIONAL INFORMATION

If more than one screen, show locations of each on sketch.