

HARRISON
K 134
6-30-72

MISSISSIPPI
 BOARD OF WATER COMMISSIONERS
 416 North State Street
 Jackson, Mississippi 39201

WATER WELL DRILLERS LOG

GODED

JUNE 30, 1972 Ladwiser's Well HARRISON
 date well completed firm name county well located

LANDOWNER: Mr. Al Graham
County Farm Road
Gulfport, Miss.
 (mailing address)

description of formations encountered	from	to
<u>Red Clay & Sand</u>	<u>0</u>	<u>60</u>
<u>Blue Clay</u>	<u>60</u>	<u>480</u>
<u>Blue Sand</u>	<u>480</u>	<u>525</u>

WELL LOCATION:
 sec. 2 T. 7 R. 12
3 miles West of LYMAN
 (distance) (direction) (nearest town)

WELL PURPOSE: HOME
 (home, irrigation, municipal, industrial)

WELL COMPLETION DATA:

(1) diameter (inches) 2 inch

(2) total depth (feet) 525 ft.

(3) static water level (feet) 50 below above top of ground.

(4) casing Galv., 515 ft.
 (material) (depth)
2 inch If telescope see back.
 (size)

(5) screen 10 ft., 515 ft.
 (length) (depth to top)
2 inch, S.S.
 (size) (material)

(6) pump _____ (HP) _____ (yield gpm)
Electric
 (type power)

(7) electric log NO
 (yes or no)

 (organization running log)


(8) how well bottom plugged Ball Check

GODED

DRILLERS REMARKS:

If well telescopes please sketch and show depths.

GROUND LEVEL

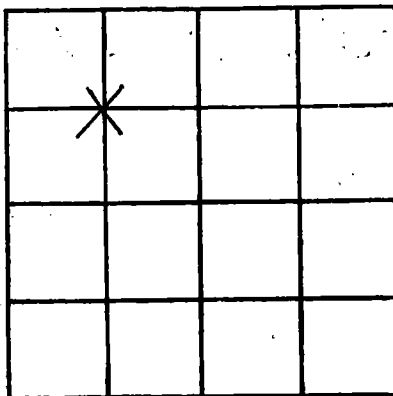

SECTION 2

Please indicate well location X.

ADDITIONAL INFORMATION

If more than one screen, show locations of each on sketch.