

HARRISON
K136
12-7-71

MISSISSIPPI
BOARD OF WATER COMMISSIONERS
416 North State Street
Jackson, Mississippi 39201
WATER WELL DRILLERS LOG

CODED

12/7 1971 Mc Gill Well Works Harrison
date well completed firm name county well located

LANDOWNER: Gene Phillips

description of formations encountered

from to

3001 51st Ave.

Red Clay 0 19
Chance sand 18 30

Huffport Miss
(mailing address)

WELL LOCATION:

sec. 10 T 7 N R 12 E
10 1/2 miles N.W of Huffport
(distance) (direction) (nearest town)

WELL PURPOSE: Home
(home, irrigation, municipal, industrial)

WELL COMPLETION DATA:

- (1) diameter (inches) 2"
(2) total depth (feet) 30'
(3) static water level (feet) 6' below above top of ground.
(4) casing plastic 20'
(material) (depth)

- (size) if telescope see back.

- (5) screen 10' -
(length) (depth to top)
2" plastic
(size) (material)

- (6) pump 1/2 7
(HP) (yield gpm)
electric
(type power)

- (7) electric log no
(yes or no)

-
(organization running log)

- (8) how well bottom plugged hard
shank


CODED

DRILLERS REMARKS:

MAY 29 1973

If well telescopes please sketch and show depths.

GROUND LEVEL

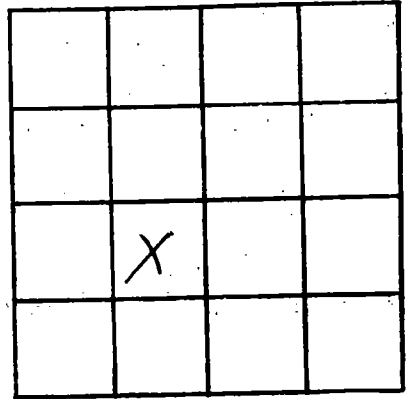

SECTION 10

Please indicate well location X.

ADDITIONAL INFORMATION

If more than one screen, show locations of each on sketch.