

HARRISON
K146
2-12-73

MISSISSIPPI
 BOARD OF WATER COMMISSIONERS
 416 North State Street
 Jackson, Mississippi 39201

WATER WELL DRILLERS LOG

Feb 12 19 73 Mc Gill well works Harrison
 date well completed firm name county well located

LANDOWNER: Michael Shelton

description of formations encountered

from

to

Pt. 1 Box 348

Huff, Miss.
 (mailing address)

WELL LOCATION:

sec. 15 T 2 N R 12 E
 11 miles West of Jordan
 (distance) (direction) (nearest town)

WELL PURPOSE: Home
 (home, irrigation, municipal, industrial)

WELL COMPLETION DATA:

CODED

- (1) diameter (inches) 2"
- (2) total depth (feet) 272'
- (3) static water level (feet) 22' below top of ground
- (4) casing gal. 25 2' (material) (depth)

CODED

(size) If telescope see back.

- (5) screen 20' (length) (depth to top)
 2" (size) J.S. (material)

- (6) pump 1 (HP) 8 (yield gpm)
 electric (type power)

- (7) electric log NO (yes or no)

(organization running log)

- (8) how well bottom plugged Sand
 Shark

DRILLERS REMARKS:


MISSISSIPPI BOARD OF WATER COMMISSIONERS

FEB 4 1974

MISS. BD. OF WATER COMM.

If well telescopes please sketch and show depths.

GROUND LEVEL

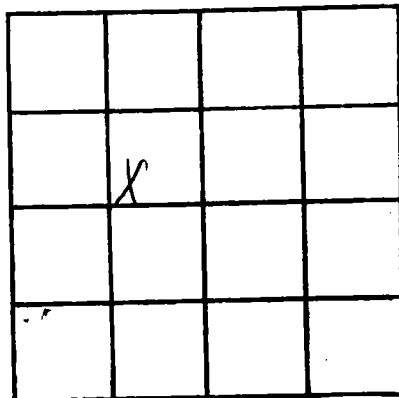

SECTION 15

Please indicate well location X.

ADDITIONAL INFORMATION

If more than one screen, show locations of each on sketch.