

HARRISON
K 147
2-16-74

MISSISSIPPI
 BOARD OF WATER COMMISSIONERS
 416 North State Street
 Jackson, Mississippi 39201

WATER WELL DRILLERS LOG

2-16-74 19 1974 R. J. Moore HARRISON
 date well completed firm name county well located

LANDOWNER: H. WILLIAMS
RT 2 Box 315
GOLESPORT, MISS
 (mailing address)
 WELL LOCATION:
 sec. 9 T. 2 N. R. 12 E.
6 miles W of LANDON
 (distance) (direction) (nearest town)

description of formations encountered	from	to
TOP SOIL	0	10
RUSTY SAND	10	25
BLUE CLAY	25	200
FINE SAND	200	240
Blue CLAY	240	470
CORSE GRAY SAND	470	530

WELL PURPOSE:
 (home, irrigation, municipal, industrial)

WELL COMPLETION DATA:
 (1) diameter (inches) 2"
 (2) total depth (feet) 530'
 (3) static water level (feet) 34' below above top of ground.
 (4) casing 9 1/2" 520'
 (material) (depth)
 If telescope see back.
 (size)
 (5) screen 10' 530'
 (length) (depth to top)
2 1/2" SS
 (size) (material)
 (6) pump _____
 (HP) (yield gpm)
 (type power)
 (7) electric log _____
 (yes or no)
 (organization running log)
 (8) how well bottom plugged
Boo Wire


CODED

DRILLERS REMARKS:

MISS. BOARD OF WATER COMMISSIONERS

If well telescopes please sketch and show depths.

GROUND LEVEL

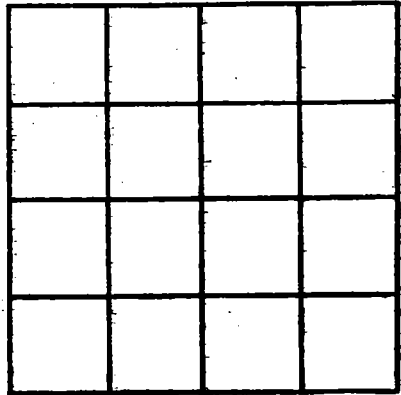

SECTION _____

Please indicate well location X.

ADDITIONAL INFORMATION

If more than one screen, show locations of each on sketch.