

HARRISON
K 148
3-5-74

MISSISSIPPI
BOARD OF WATER COMMISSIONERS
416 North State Street
Jackson, Mississippi 39201

CODED

WATER WELL DRILLERS LOG

5 March 1974 Bryant Well Co Harrison
date well completed firm name county well located

LANDOWNER: GEORGE REED
PO Box 405
Long Beach Miss.
(mailing address)

WELL LOCATION: 12
sec 23 T 7 S R 12 W
5 miles N of Pass Christian
(distance) (direction) (nearest town)

WELL PURPOSE: HOME
(home, irrigation, municipal, industrial)


WELL COMPLETION DATA:

- (1) diameter (inches) 2
- (2) total depth (feet) 231
- (3) static water level (feet) 25 below
top of ground above
- (4) casing PVC, 221
(material) (depth)
- _____ If telescope see back.
(size)
- (5) screen 10, 221
(length) (depth to top)
2" STAINLESS WDP
(size) (material)
- (6) pump 1/2, 9
(HP) (yield gpm)
ELECT
(type power)
- (7) electric log _____
(yes or no)
- _____ (organization running log)

(8) how well bottom plugged BRONZE
BACK PARSANE YANK


DRILLERS REMARKS: 26 FEET OF
2" PVC BELOW SCREEN

description of formations encountered	from	to
CLAY RED	0	5
SAND RED	5	30
CLAY RED	30	67
SAND RED	67	97
CLAY BLUE	97	169
SAND FINE	169	192
CLAY BLUE	192	197
SAND FINE	197	193
CLAY BLUE	193	199
SAND COARSE	199	209
CLAY BLUE	209	231
CODED		

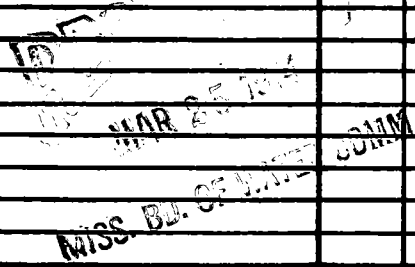

If well telescopes please sketch and show depths.

GROUND LEVEL

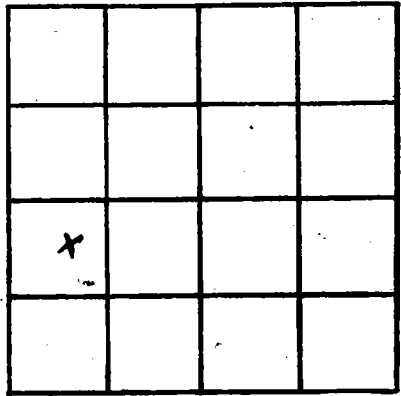

X			

SECTION 28

Please indicate well location X.

ADDITIONAL INFORMATION

If more than one screen, show locations of each on sketch.