

K 150  
 HARRISON  
 6-29-73

MISSISSIPPI  
 BOARD OF WATER COMMISSIONERS  
 416 North State Street  
 Jackson, Mississippi 39201

WATER WELL DRILLERS LOG

June 27 1973 Ward well works Harrison  
 date well completed firm name county well located

LANDOWNER: Larry Brown description of formations encountered from to  
Red Creek Road  
Long Beach Miss (mailing address)  
Couace Sand 0 87  
Slush 87 166  
Couace Sand 160 190

WELL LOCATION:  
 sec. 21 T. 7 N R. 12 E  
S miles NW of Long Beach  
 (distance) (direction) (nearest town)

WELL PURPOSE: Home  
 (home, irrigation, municipal, industrial)

- WELL COMPLETION DATA:
- (1) diameter (inches) 2"
  - (2) total depth (feet) 190'
  - (3) static water level (feet) 27' below above top of ground.
  - (4) casing plastic 180'  
 (material) (depth)  
 (size) if telescope see back.
  - (5) screen 10' (length) (depth to top)  
2" (size) plastic (material)
  - (6) pump 1 (HP) 13 (yield gpm)  
electric (type power)
  - (7) electric log NO (yes or no)
  - (organization running log)
  - (8) how well bottom plugged sand  
mark


CODED

MISSISSIPPI BOARD OF WATER COMMISSIONERS  
 JUN 29 1973  
 MAT 2 1973  
 MISSISSIPPI BOARD OF WATER COMMISSIONERS

DRILLERS REMARKS:

If well telescopes please sketch and show depths.

GROUND LEVEL

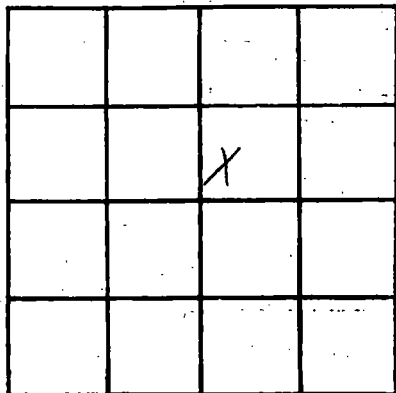

SECTION 21

Please indicate well location X.

ADDITIONAL INFORMATION

If more than one screen,  
show locations of each on sketch.