

HARRISON
K151
7-10-74

MISSISSIPPI
BOARD OF WATER COMMISSIONERS
416 North State Street
Jackson, Mississippi 39201

CODED

WATER WELL DRILLERS LOG

7-10-74 19 R. J. Moore HARRISON
date well completed firm name county well located

LANDOWNER Garcia White
Bryan Bonard RD
Gulfport
(mailing address)

description of formations encountered	from	to
TOP SOIL	0	10
White Sand	10	18
Blue CLAY	18	240
FINE Blue Sand	240	280
Blue Clay	280	300
FINE Blue Sand	300	315
CLAY	315	373
good sand	373	380
CLAY	380	470
COARSE SAND	470	520

WELL LOCATION:
sec. 11 T. 7 N. R. 12E
5 miles W of LADAN
(distance) (direction) (nearest town)

WELL PURPOSE:
(home, irrigation, municipal, industrial)

WELL COMPLETION DATA:
(1) diameter (inches) 2"
(2) total depth (feet) 520'
(3) static water level (feet) 43' below top of ground.
(4) casing PUC 500' (material) (depth)
(size) if telescope see back.
(5) screen 20' 500' (length) (depth to top)
2" PUC (size) (material)
(6) pump 1 1/2 15 (HP) (yield gpm)
8 (type power)
(7) electric log (yes or no)
(organization running log)
(8) how well bottom plugged Bad Water


DRILLERS REMARKS:

RECORDED
NOV 16 1974

MISS. BD. OF WATER COMMISSIONERS

If well telescopes please sketch and show depths.

GROUND LEVEL

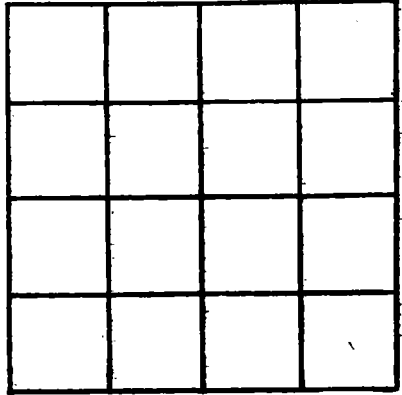

SECTION _____

Please indicate well location X.

ADDITIONAL INFORMATION

If more than one screen, show locations of each on sketch.