

**HARRISON**  
**K152**  
**8/20/74**

MISSISSIPPI  
 BOARD OF WATER COMMISSIONERS  
 416 North State Street  
 Jackson, Mississippi 39201

**CODED**

**WATER WELL DRILLERS LOG**

8-20-74 19 R. J. Moore HARRISON  
 date well completed firm name county well located

LANDOWNER: H. E. Setford Jr  
2801 SUNSET AVE  
Gulfport, MISS  
 (mailing address)

description of formations encountered	from	to
TOP SOIL	0	10
TOP SAND	10	60
CLAY	60	270
GRAVEL SAND	270	322

WELL LOCATION:  
 sec 36 T 7 N R 12 E  
U miles N of Lumberton  
 (distance) (direction) (nearest town)

WELL PURPOSE:  
 (home, irrigation, municipal, industrial)

WELL COMPLETION DATA:

(1) diameter (inches) 2"

(2) total depth (feet) 322'

(3) static water level (feet) 9' <sup>below</sup> <sub>above</sub> top of ground.

(4) casing Alum 312'  
 (material) (depth)  
 (size) If telescope see back.

(5) screen 10' 312'  
 (length) (depth-to-top)  
2" SS  
 (size) (material)

(6) pump 1 12  
 (HP) (yield gpm)  
E  
 (type power)

(7) electric log \_\_\_\_\_  
 (yes or no)  
 \_\_\_\_\_  
 (organization running log)

(8) how well bottom plugged \_\_\_\_\_


**CODED**

DRILLERS REMARKS:

MISS. BD. OF WATER COMM

If well telescopes please sketch and show depths.

GROUND LEVEL

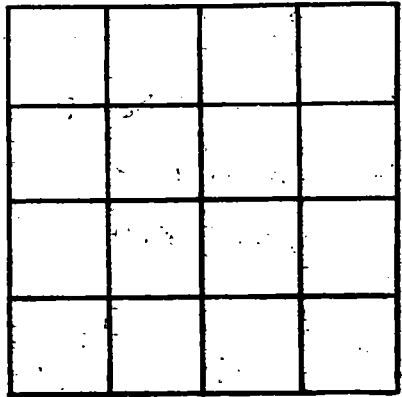

SECTION \_\_\_\_\_

Please indicate well location X.

ADDITIONAL INFORMATION

If more than one screen, show locations of each on sketch.