

Harrison
K154
7-31-74

MISSISSIPPI
 BOARD OF WATER COMMISSIONERS
 416 North State Street
 Jackson, Mississippi 39201

CODED

WATER WELL DRILLERS LOG

July 31 1974 H.A. Ladnier's Well Works Harrison
 date well completed firm name county well located

LANDOWNER: <u>S.W. Maggee</u> <u>Hotten Rd</u>	description of formations encountered	from	to
<u>London, MS</u> (mailing address)	<u>yellow clay</u>	<u>0</u>	<u>35</u>
WELL LOCATION: sec <u>2</u> T <u>7</u> S R <u>B</u> W	<u>yellow sand</u>	<u>35</u>	<u>65</u>
<u>3</u> miles <u>W</u> of <u>London</u> (distance) (direction) (nearest town)	<u>yellow clay</u>	<u>65</u>	<u>110</u>
WELL PURPOSE: <u>home</u> (home, irrigation, municipal, industrial)	<u>blue clay</u>	<u>110</u>	<u>315</u>
WELL COMPLETION DATA: (1) diameter (inches) <u>2 in.</u>	<u>blue earth</u>	<u>315</u>	<u>360</u>
(2) total depth (feet) <u>360 ft.</u>			
(3) static water level (feet) <u>30</u> <u>4</u> <u>low</u> top of ground.			
(4) casing <u>galv.</u> <u>350</u> (material) (depth)			
<u>2 in.</u> (size) if telescope see back.			
(5) screen <u>10ft.</u> <u>350</u> (length) (depth to top)			
<u>2 in.</u> <u>s. steel</u> (size) (material)			
(6) pump <u>1</u> <u>8</u> (HP) (yield gpm)			
<u>elec.</u> (type power)			
(7) electric log <u>no</u> (yes or no)			
(organization running log)			
(8) how well bottom plugged <u>ballcheck</u>			
DRILLERS REMARKS:			


REGISTERED
 REG

NOV - 4 1974

MISS. BD. OF WATER COMM

If well telescopes please sketch and show depths.

GROUND LEVEL

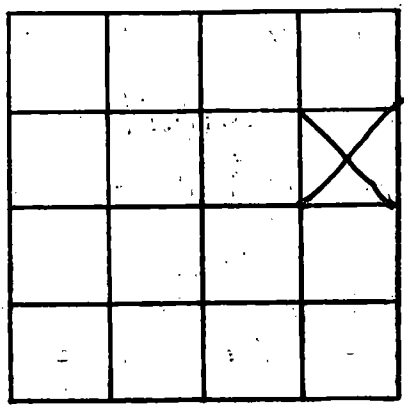

SECTION 2

Please indicate well location X.

ADDITIONAL INFORMATION

A series of horizontal lines for writing additional information.

If more than one screen, show locations of each on sketch.