

**Harrison**  
**K 155**  
**10-30-74**

MISSISSIPPI  
 BOARD OF WATER COMMISSIONERS  
 416 North State Street  
 Jackson, Mississippi 39201

CODED

WATER WELL DRILLERS LOG

Oct. 30 19 74 Ladnier's Well Works Harrison  
 date well completed firm name county well located

LANDOWNER: Joe Anderson  
Creed Circle  
Handsbora Ms  
 (mailing address)

| description of formations encountered | from       | to         |
|---------------------------------------|------------|------------|
| <u>yellow clay</u>                    | <u>0</u>   | <u>30</u>  |
| <u>yellow sand</u>                    | <u>30</u>  | <u>100</u> |
| <u>yellow clay</u>                    | <u>100</u> | <u>300</u> |
| <u>blue sand</u>                      | <u>300</u> | <u>326</u> |

WELL LOCATION:  
 sec. 2 T. 7 S. R. 10  
3 miles N of Handsbora  
 (distance) (direction) (nearest town)

WELL PURPOSE: none  
 (home, irrigation, municipal, industrial)

- WELL COMPLETION DATA:
- (1) diameter (inches) 2 in.
  - (2) total depth (feet) 326
  - (3) static water level (feet) 25 below top of ground.
  - (4) casing plastic, 326  
 (material) (depth)  
2 in. if telescope see back.  
 (size)
  - (5) screen 10 ft., 326 ft.  
 (length) (depth to top)  
2 in., plastic  
 (size) (material)
  - (6) pump 1 10  
 (HP) (yield gpm)  
elec  
 (type power)
  - (7) electric log No  
 (yes or no)
- (organization running log)


(8) how well bottom plugged ball check

DRILLERS REMARKS:

REGISTERED  
 NOV - 4 1974

If well telescopes please sketch and show depths.

GROUND LEVEL

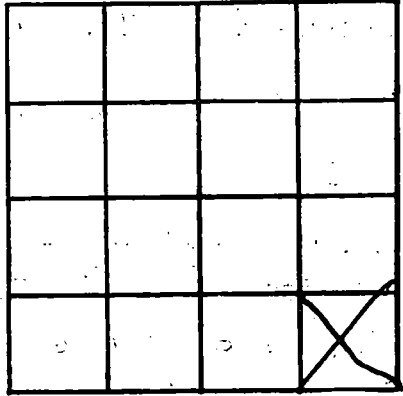

SECTION 2

Please indicate well location X.

ADDITIONAL INFORMATION

If more than one screen, show locations of each on sketch.