

Harrison
K 156
9-3-73

MISSISSIPPI
 BOARD OF WATER COMMISSIONERS
 416 North State Street
 Jackson, Mississippi 39201

COBEP

WATER WELL DRILLERS LOG


September 3, 1973 H.A. Ladwice's Well Works HARRISON
 date well completed firm name county well located

LANDOWNER: <u>WAYNE YORK</u>	description of formations encountered	from	to
<u>Sky line Hills</u>			
<u>PASS CHRISTIAN, MISS.</u> (mailing address)	<u>yellow clay</u>	<u>0</u>	<u>50</u>
	<u>yellow sand</u>	<u>50</u>	<u>65</u>
	<u>yellow clay</u>	<u>65</u>	<u>135</u>
	<u>blue clay</u>	<u>135</u>	<u>255</u>
	<u>blue sand</u>	<u>255</u>	<u>280</u>
WELL LOCATION:			
sec. <u>S 7</u> T. <u>7</u> S. R. <u>12</u> E. W.			
<u>20</u> miles <u>NE</u> of <u>DeLisle</u>			
(distance) (direction) (nearest town)			
WELL PURPOSE: <u>HOME</u> (home, irrigation, municipal, industrial)			
WELL COMPLETION DATA:			
(1) diameter (inches) <u>2 inch</u>			
(2) total depth (feet) <u>280 FT.</u>			
(3) static water level (feet) <u>75</u> below top of ground.			
(4) casing <u>Galv.</u> <u>270 FT.</u> (material) (depth)			
<u>2 inch</u> (size) if telescope see back.			
(5) screen <u>10 FT.</u> <u>270 FT.</u> (length) (depth to top)			
<u>2 inch, Stainless Steel</u> (size) (material)			
(6) pump <u>1</u> <u>6</u> (HP) (yield gpm)			
<u>Electric</u> (type power)			
(7) electric log <u>No</u> (yes or no)			
(organization running log)			
(8) how well bottom plugged <u>Ball Check</u>			
DRILLERS REMARKS:			
NOV - 4 1974			

DISCOVER

If well telescopes please sketch and show depths.

GROUND LEVEL

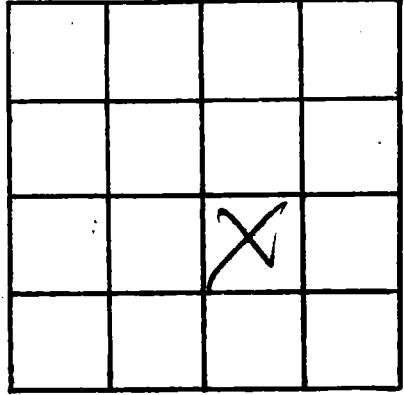

SECTION 5

Please indicate well location X.

ADDITIONAL INFORMATION

If more than one screen, show locations of each on sketch.