

Harrison
K157
9-18-73

MISSISSIPPI
BOARD OF WATER COMMISSIONERS
416 North State Street
Jackson, Mississippi 39201

CODED

WATER WELL DRILLERS LOG

September 18 1973 H. A. Hadavice's Well Works Harrison
Date well completed firm name county well located


LANDOWNER:	description of formations encountered	from	to
Hutter Rd. Landon MS (mailing address)			
WELL LOCATION: sec. 2 T 7 S R 12 W 3 miles W of Landon (distance) (direction) (nearest town)	yellow clay yellow sand blue clay blue sand.	0 60 100 195	60 100 205 232
WELL PURPOSE: HOMEY (home, irrigation, municipal, industrial)			
WELL COMPLETION DATA: (1) diameter (inches) 2 inch (2) total depth (feet) 232 ft. (3) static water level (feet) 25 below top of ground. (4) casing Galv. 222 ft. (material) (depth) 2 inch (size) if telescope see back. (5) screen 10 ft. 222 ft. (length) (depth to top) 2 inch STAINLESS STEEL (size) (material) (6) pump 1 (HP) 8 (yield gpm) Electric (type power) (7) electric log No (yes or no) (organization running log) (8) how well bottom plugged Ball Check			
DRILLERS REMARKS:			

RECEIVED

NOV - 4 1974

If well telescopes please sketch and show depths.

GROUND LEVEL

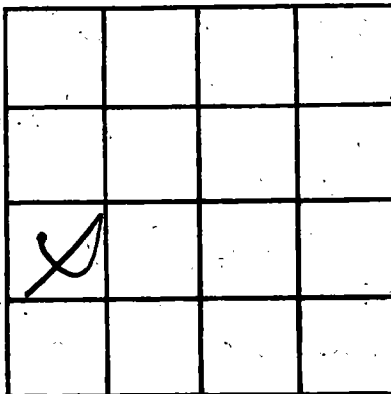

SECTION 2

Please indicate well location X.

ADDITIONAL INFORMATION

If more than one screen, show locations of each on sketch.