

# Harrison

2. W  
K 159  
3-19-74

MISSISSIPPI  
 BOARD OF WATER COMMISSIONERS  
 416 North State Street  
 Jackson, Mississippi 39201

CODED

### WATER WELL DRILLERS LOG

March 14 1974 McCall Well Works Harrison  
 Date well completed firm name county well located

LANDOWNER:	description of formations encountered	from	to
<u>E. W. Cole</u>			
<u>4110 Franklin Ave</u> <small>(mailing address)</small>	<u>Sand</u>	<u>0</u>	<u>30</u>
<u>Shelton, Miss</u>	<u>Blue clay</u>	<u>30</u>	<u>41</u>
	<u>course sand</u>	<u>41</u>	<u>60</u>
WELL LOCATION:			
sec. <u>25</u> T. <u>7</u> N. R. <u>12</u> E. <u>3 1/2</u> miles <u>E</u> of <u>Shelton</u> <small>(distance) (direction) (nearest town)</small>			
WELL PURPOSE: <u>Irrigation</u> <small>(home, irrigation, municipal, industrial)</small>			
WELL COMPLETION DATA:			
(1) diameter (inches) <u>2"</u>			
(2) total depth (feet) <u>60'</u>			
(3) static water level (feet) <u>4'</u> <u>below</u> top of ground <u>above</u>			
(4) casing <u>P.V.C.</u> <u>50'</u> <small>(material) (depth)</small>			
<u>—</u> If telescope see back. <small>(size)</small>			
(5) screen <u>10'</u> <u>50'</u> <small>(length) (depth to top)</small>			
<u>2"</u> <u>P.V.C.</u> <small>(size) (material)</small>			
(6) pump <u>1/2</u> <u>12</u> <small>(HP) (yield gpm)</small>			
<u>electric</u> <small>(type power)</small>			
(7) electric log <u>no</u> <small>(yes or no)</small>			
<u>—</u> <small>(organization running log)</small>			
(8) how well bottom plugged <u>Capped</u>			
DRILLERS REMARKS:			

CODED


RECEIVED  
 DECEMBER 21 1974

JAN 21 1975

MISS. BD. OF WATER COMM.

If well telescopes please sketch and show depths.

GROUND LEVEL

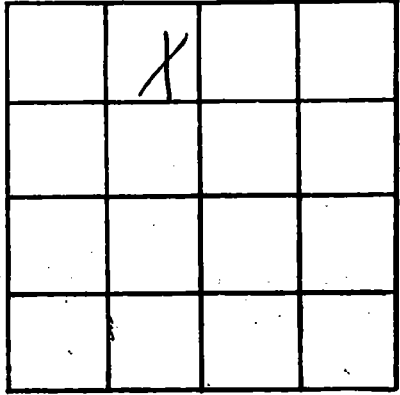

SECTION

25

Please indicate well location X.

ADDITIONAL INFORMATION

If more than one screen, show locations of each on sketch.